

MISSISSIPPI DEPARTMENT OF NATURAL RESOURCES

Bureau of Land and Water Resources

Southport Mall

P.O. Box 10631

Jackson, Mississippi 39209

WATER WELL DRILLERS LOG


HARRISON
FB
2044

April 9 1986 McGree Harrison
 date well completed firm name county well located

LANDOWNER: <u>Jim Chinayee</u>	description of formations encountered	from	to
(mailing address)	<u>0 Sand</u>	<u>0</u>	<u>30</u>
WELL LOCATION: <u>5</u> sec. <u>31</u> T. <u>8</u> N. R. <u>13</u> E. (distance) miles <u>5</u> <u>West</u> of <u>Saurin</u> (direction) (nearest town)	<u>mud</u>	<u>30</u>	<u>160</u>
WELL PURPOSE: <u>home</u> (home, irrigation, municipal, industrial)	<u>Sand</u>	<u>160</u>	<u>300</u>
WELL COMPLETION DATA: (1) diameter (inches) <u>2"</u> (2) total depth (feet) <u>300'</u> (3) static water level (feet) <u>80'</u> <u>below</u> above top of ground. (4) casing <u>PVC</u> , <u>280</u> , (material) (depth) <u>2"</u> If telescope see back. (size) (5) screen <u>10'</u> , <u>Bottom</u> (length) (depth to top) <u>2"</u> , <u>PVC</u> (size) (material) (6) pump <u>1</u> <u>11</u> (HP) (yield gpm) <u>Electric</u> (type power) (7) electric log <u>no</u> (yes or no) (organization running log) (8) how well bottom plugged <u>Seal</u>	<div data-bbox="677 1215 1090 1406" data-label="Text"> <p>RECEIVED AUG 7 1986</p> </div> <div data-bbox="665 1423 1044 1519" data-label="Text"> <p>Department of Natural Resources Bureau of Land & Water Resources</p> </div>		
DRILLERS REMARKS:			

If well telescopes please sketch and show depths.

GROUND LEVEL

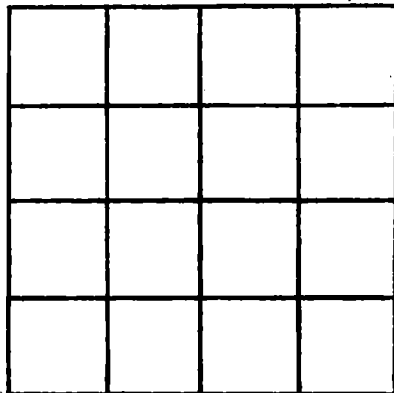

SECTION _____

Please indicate well location X.

ADDITIONAL INFORMATION

If more than one screen, show locations of each on sketch.