

MISSISSIPPI DEPARTMENT OF NATURAL RESOURCES

Bureau of Land and Water Resources

Southport Mall

P.O. Box 10631

Jackson, Mississippi 39209

WATER WELL DRILLERS LOG

Harrison
B 245

5-14- 19 86
date well completed

Frank Price
firm name

Harrison
county well located

LANDOWNER:

Marvel Bosch

(mailing address)

WELL LOCATION:

sec. 15 T. 5 S. R. 12 E
3 miles SW of Jackson
(distance) (direction) (nearest town)

WELL PURPOSE: HOME
(home, irrigation, municipal, industrial)

WELL COMPLETION DATA:

- (1) diameter (inches) 2"
- (2) total depth (feet) 245'
- (3) static water level (feet) 20' below above top of ground.
- (4) casing PVC, 240'
(material) (depth)
(size) if telescope see back.
- (5) screen 10', 240'
(length) (depth to top)
2", PVC
(size) (material)
- (6) pump 1 (HP) 8 (yield gpm)
Elect.
(type power)
- (7) electric log NO.
(yes or no)

(organization running log)

(8) how well bottom plugged B.W.V.

description of formations encountered

from to

<u>Top Soil</u>	<u>0</u>	<u>2</u>
<u>Red Clay</u>	<u>2</u>	<u>18</u>
<u>Blue Clay</u>	<u>18</u>	<u>238</u>
<u>Medium Sand</u>	<u>238</u>	<u>240</u>

RECEIVED


AUG 18 1986

Department of Natural Resources
Bureau of Land & Water Resources

DRILLERS REMARKS:

If well telescopes please sketch and show depths.

GROUND LEVEL

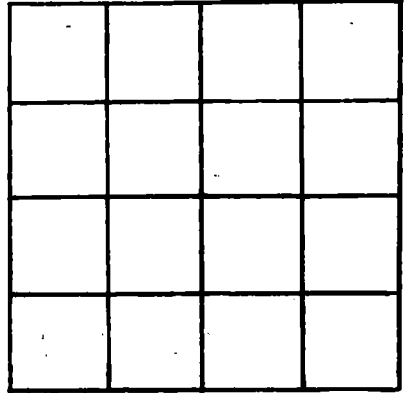

SECTION _____

Please indicate well location X.

ADDITIONAL INFORMATION

If more than one screen, show locations of each on sketch.