

MISSISSIPPI DEPARTMENT OF NATURAL RESOURCES

Bureau of Land and Water Resources

Southport Mall

P.O. Box 10631

Jackson, Mississippi 39209

WATER WELL DRILLERS LOG

HARRISON
B 2046

8/28/86 19 Lyman Well Harrison
date well completed firm name county well located

LANDOWNER: David Crvin
Rt. 3, Box 149-C
Saucier, MS 39574
(mailing address)

description of formations encountered	from	to
<u>Top soil</u>		<u>1'</u>
<u>Sand & clay</u>	<u>1'</u>	<u>6'</u>
<u>Sand</u>	<u>6'</u>	<u>23'</u>
<u>Blue Clay</u>	<u>23'</u>	<u>107'</u>
<u>Sand</u>	<u>107'</u>	<u>124'</u>
<u>Blue Clay</u>	<u>124'</u>	<u>200'</u>
<u>Sand</u>	<u>200'</u>	<u>215'</u>

WELL LOCATION:
sec. 11 T. 5 N R. 12 E
(distance) miles (direction) of Saucier (nearest town)

WELL PURPOSE: Home
(home, irrigation, municipal, industrial)

WELL COMPLETION DATA:

- (1) diameter (inches) 2"
- (2) total depth (feet) 215'
- (3) static water level (feet) 53' below above top of ground.
- (4) casing PVC, 205'
(material) (depth)
- 2" if telescope see back.
(size)
- (5) screen 10', 205'
(length) (depth to top)
- 2", PVC
(size) (material)
- (6) pump 1 (HP) 1 (yield gpm)
- electric
(type power)
- (7) electric log NO
(yes or no)
NO
(organization running log)

RECEIVED

OCT 28 1986


Department of Natural Resources
Bureau of Land & Water Resources

(8) how well bottom plugged sand
shuck

DRILLERS REMARKS: None

If well telescopes please sketch and show depths.

GROUND LEVEL

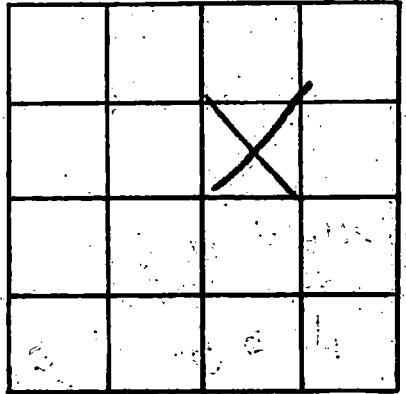

SECTION 11

Please indicate well location X.

ADDITIONAL INFORMATION

A series of horizontal lines for writing additional information.

If more than one screen, show locations of each on sketch.