

MISSISSIPPI DEPARTMENT OF NATURAL RESOURCES

Bureau of Land and Water Resources

Southport Mall

P.O. Box 10631

Jackson, Mississippi 39209

WATER WELL DRILLERS LOG

HARRISON
B2018

8-26-86
date well completed

Coastwaterwell Harrison
firm name county well located

LANDOWNER: James Allen

Rt 6 Box 77 RHME

Biloxi MS 39532

(mailing address)

WELL LOCATION:

sec 31 T 5 N R 12 E
2 miles N of LIZANA
(distance) (direction) (nearest town)

WELL PURPOSE: home

(home, irrigation, municipal, industrial)

WELL COMPLETION DATA:

- (1) diameter (inches) 2"
- (2) total depth (feet) 83'
- (3) static water level (feet) 31 below above top of ground.
- (4) casing PVC, 68',
(material) (depth),
2" If telescope see back.
(size)
- (5) screen 10', 68'
(length) (depth to top)
2", PVC
(size) (material)
- (6) pump _____
(HP) (yield gpm)
(type power)
- (7) electric log no
(yes or no)
(organization running log)

- (8) how well bottom cased backwash valve

DRILLERS REMARKS:

5 ft 2" PVC tail pipe

Description of formations encountered

from

to

Top Soil

0

5

Red Clay

5

10

Red Med Sand

10

20

Blue Clay

20

50

Red Clay

50

65

Red Course Sand

65

78

Blue Clay

78

83


RECEIVED

SEP 11 1986

Department of Natural Resources
Bureau of Land & Water Resources

If well telescopes please sketch and show depths.

GROUND LEVEL

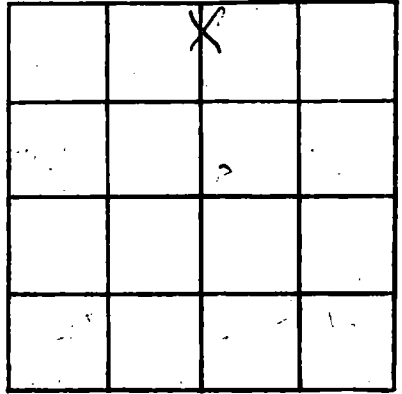

SECTION 31

Please indicate well location X.

ADDITIONAL INFORMATION

If more than one screen, show locations of each on sketch.