

Bureau of Land and Water Resources

Southport Mall

P.O. Box 10631

Jackson, Mississippi 39209

WATER WELL DRILLERS LOG

HARRISON  
B 2049

3-31  
date well completed

1986 Braden Pump & Well Service  
firm name

Harrison  
county well located

LANDOWNER: <u>Lowell K. Knoble</u>	description of formations encountered	from	to
<u>Rt. 3 Box 431</u>			
<u>Yankee Turn Rd - Saucier, Ms.</u> (mailing address) <u>39574</u>	<u>Surface</u>	<u>0</u>	<u>4</u>
	<u>Red Clay</u>	<u>4</u>	<u>18</u>
	<u>White Sand</u>	<u>18</u>	<u>38</u>
	<u>White Clay</u>	<u>38</u>	<u>58</u>
	<u>Blue Clay</u>	<u>58</u>	<u>220</u>
	<u>Grey Sand</u>	<u>220</u>	<u>250</u>
	<u>Blue Clay</u>	<u>250</u>	<u>260+</u>
WELL LOCATION: sec. <u>24</u> T. <u>5</u> S. R. <u>12</u> E. W. <u>3</u> S. of <u>Saucier</u> (distance) (direction) (nearest town)			
WELL PURPOSE: <u>Home</u> (home, irrigation, municipal, industrial)			
WELL COMPLETION DATA:			
(1) diameter (inches) <u>4" X 2"</u>			
(2) total depth (feet) <u>250</u>			
(3) static water level (feet) <u>50</u> below top of ground.			
(4) casing (material) <u>4" X 2"</u> , (depth) <u>240</u>			
<u>4" X 2"</u> if telescope see back. (size)			
(5) screen (length) <u>10</u> , (depth to top) <u>240</u>			
<u>2"</u> (size), <u>PRC</u> (material)			
(6) pump (HP) <u>1</u> , (yield gpm) <u>20</u>			
<u>220V 1Ø</u> (type power)			
(7) electric log <u>No</u> (yes or no)			
(organization running log)			
(8) how well bottom plugged <u>2" PRC Sand Shark</u>			
DRILLERS REMARKS: <u>10 ft Tailpipe</u>			

Braden Pump & Well Service, Inc.  
Rt. 1, Box 676  
Saucier, MS 39574

RECEIVED

FEB 25 1987

Department of Natural Resources  
Bureau of Land & Water Resources

If well telescopes please sketch and show depths.

GROUND LEVEL

44  
PVC

150 FT

24  
PVC

240 FT

250 FT →


2" PVC →

44" x 24" PVC  
Bushing

2" x 10 FT  
PVC Screen

2" PVC  
Sand Shark

231 22112 110W 2 4000  
Box 878  
33274 2M 10000

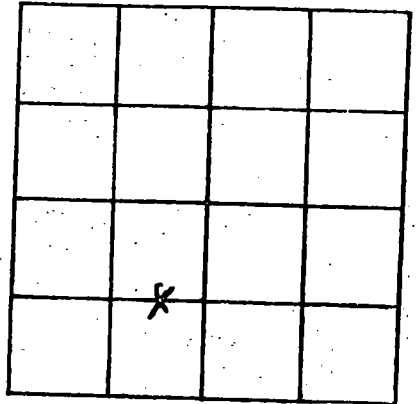

SECTION 24

Please indicate well location X.

ADDITIONAL INFORMATION

If more than one screen,  
show locations of each on sketch.