

MISSISSIPPI DEPARTMENT OF NATURAL RESOURCES
Bureau of Land and Water Resources

P.O. Box 10631

Jackson, Mississippi 39209

WATER WELL DRILLERS LOG

COUNTY WELL LOCATED
Harrison

WELL NUMBER CODED
B 2050

DATE WELL COMPLETED
2-14-87

PERMIT NUMBER

NAME OF DRILLING FIRM
Broden Pump Works

NAME & MAILING ADDRESS OF LANDOWNER
Louis Pecaul

Rt 3 Box 320 W

Sauvier, Miss. 39504

WELL LOCATION: SEC *14* TOWNSHIP *5 S* RANGE *12 W*

DISTANCE *2* Miles DIRECTION *SE* of NEAREST TOWN *Sauvier*

OTHER LANDMARK

WELL PURPOSE: Home, Irrigation, Municipal, Industrial, Fish Pond, etc.
Home

PUMP DATA

PUMP TYPE (Circle One):
Submersible, Turbine, Jet Flowing Well,
Other (Describe)

POWER TYPE (Circle One):
Electric Tractor, Diesel, Gasoline, Butane,
Other (Describe)

Pump Capacity (GPM) No. of Stages Setting Depth
10 *2* *80* FT.

PUMP TEST

Well yielded *10* GPM with
a drawdown of _____ ft.
after _____ hours of pumping

WELL DATA

Well Depth <i>310</i>	Casing Diameter (In.) <i>2"</i>	Casing Length (Ft.) <i>Total</i>
Type of Casing <i>PVC</i>	Hole Depth <i>310</i>	Depth to Static Water Level <i>55</i>

TYPE OF COMPLETION: (Circle One or More):
Natural Development, Underreamed, Telescoped,
Open Hole, Other

Top of Lap Pipe or Reduction in Casing

FEET IF TELESCOPED OR MORE THAN ONE SCREEN: USE BACK PAGE

LOG DATA

TYPE OF LOG RUN (Circle One): No Log Run,
Electric, Gamma Ray, Density, Sonic, Neutron,
Other (Describe)

Name of Organization Running Log

SCREEN DATA

Diameter - Inches <i>2"</i>	Length - Feet <i>10</i>	Slot Size - Inches <i>.008</i>
Screen Type <i>PVC Wrapped</i>	Depth to Bottom - Feet <i>300</i>	

GEOLOGIC DATA (Office Use Only)

Surface Elev.	Geologic Unit	Unit Thickness	Depth to Top
Subs. SWL	Date	Analysis	Aquifer Test

Driller's Remarks

RECEIVED


DESCRIPTION OF FORMATIONS ENCOUNTERED	FROM TO		FORMATIONS (Continued)	FROM TO	
	FROM	TO		FROM	TO
<i>Surface</i>	<i>0</i>	<i>6</i>	<i>FEB 25 1987</i>		
<i>Brown clay</i>	<i>6</i>	<i>22</i>			
<i>White clay</i>	<i>22</i>	<i>86</i>			
<i>Blue clay</i>	<i>86</i>	<i>250</i>			
<i>Grey Sand</i>	<i>250</i>	<i>300</i>			
<i>& the Clay</i>	<i>300</i>	<i>310</i>	<i>+</i>		

Department of Natural Resources
Bureau of Land & Water Resources

IF MORE SPACE IS NEEDED, USE BACK

If well telescopes please sketch and show depths.

GROUND LEVEL

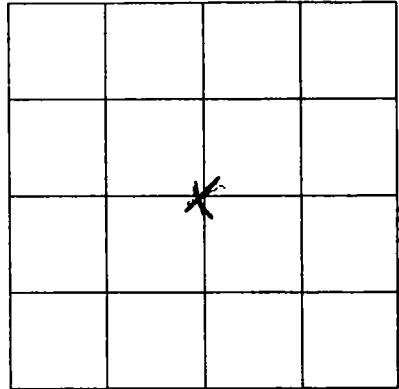

SECTION 17

Please indicate well location X.

ADDITIONAL INFORMATION

Lined area for additional information.

If more than one screen, show location of each on sketch.