

MISSISSIPPI DEPARTMENT OF NATURAL RESOURCES
Bureau of Land and Water Resources

P.O. Box 10631
Jackson, Mississippi 39209
WATER WELL DRILLERS LOG

COUNTY WELL LOCATED Harrison	
WELL NUMBER B 2555	CODED
DATE WELL COMPLETED April 2-1987	

PERMIT NUMBER 0-239
NAME OF DRILLING FIRM MCGILL PUMP & WELLS
RT1 BOX 1643 CANAL RD GUPT, MS 39503

NAME & MAILING ADDRESS OF LANDOWNER Cordele Anderson Diamond Rd Saucier, Ms.			
WELL LOCATION:	SEC	TOWNSHIP	RANGE
	335	12	12
DISTANCE	DIRECTION	NEAREST TOWN	
3 Miles	South	of Saucier	
OTHER LANDMARK			
WELL PURPOSE: <input checked="" type="radio"/> Home, <input type="radio"/> Irrigation, <input type="radio"/> Municipal, <input type="radio"/> Industrial, <input type="radio"/> Fish Pond, etc.			

PUMP DATA			
PUMP TYPE (Circle One): Submersible, Turbine, <input checked="" type="radio"/> Jet, Flowing Well, Other (Describe) _____			
POWER TYPE (Circle One): <input checked="" type="radio"/> Electric, <input type="radio"/> Tractor, <input type="radio"/> Diesel, <input type="radio"/> Gasoline, <input type="radio"/> Butane, Other (Describe) _____			
Pump Capacity (GPM) 10	No. of Stages 2	Setting Depth 100'	FT.
PUMP TEST			
Well yielded 8 GPM with a drawdown of 5 ft. after 1 hours of pumping			

WELL DATA		
Well Depth 290'	Casing Diameter (In.) 2"	Casing Length (Ft.) 20'
Type of Casing PVC	Hole Depth 290'	Depth to Static Water Level 90'
TYPE OF COMPLETION: (Circle One or More): <input checked="" type="radio"/> Gravel Packed, <input type="radio"/> Underreamed, <input type="radio"/> Telescoped, <input checked="" type="radio"/> Natural Development, <input type="radio"/> Open Hole, <input type="radio"/> Other (Describe) _____		
Top of Lap Pipe or Reduction in Casing		
FEET	IF TELESCOPED OR MORE THAN ONE SCREEN: USE BACK PAGE	

LOG DATA	
TYPE OF LOG RUN (Circle One): <input checked="" type="radio"/> No Log Run, <input type="radio"/> Electric, <input type="radio"/> Gamma Ray, <input type="radio"/> Density, <input type="radio"/> Sonic, <input type="radio"/> Neutron, Other (Describe) <u> </u>	
Name of Organization Running Log	

SCREEN DATA		
Diameter - Inches 2"	Length - Feet 10'	Slot Size - Inches 6
Screen Type 0ch 80 PVC	Depth to Bottom - Feet 290'	


GEOLOGIC DATA (Office Use Only)			
Surface Elev.	Geologic Unit	Unit Thickness	Depth to Top
Subs. SWL	Date	Analysis	Aquifer Test
Driller's Remarks			

DESCRIPTION OF FORMATIONS ENCOUNTERED	FROM	TO	FORMATIONS (Continued)	FROM	TO
Mud	0	10	RECEIVED MAY 27 1987 Department of Natural Resources Bureau of Land & Water Resources		
Sand	10	40			
Mud	40	130			
Sand	130	140			
mud	140	210			
Sand	210	290			

IF MORE SPACE IS NEEDED, USE BACK

If well telescopes please sketch and show depths.

GROUND LEVEL

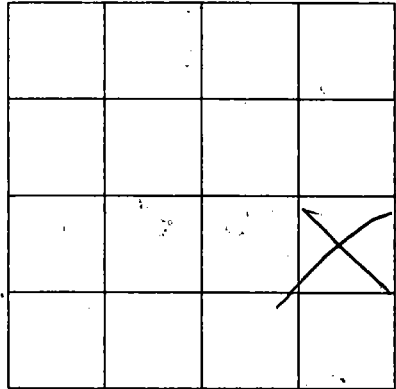

SECTION _____

Please indicate well location X.

ADDITIONAL INFORMATION

If more than one screen,
show location of each on sketch.