

**MISSISSIPPI DEPARTMENT OF NATURAL RESOURCES**  
Bureau of Land and Water Resources

P.O. Box 10631  
Jackson, Mississippi 39209  
**WATER WELL DRILLERS LOG**

COUNTY WELL LOCATED <i>Harrison</i>	
WELL NUMBER <i>B 2060</i>	CODED
DATE WELL COMPLETED <i>4-4-87</i>	

PERMIT NUMBER
NAME OF DRILLING FIRM <i>M &amp; B Drilling Co</i>

NAME & MAILING ADDRESS OF LANDOWNER <i>Ray Nolan</i> <i>1319 Piker</i> <i>Grand Junction, Colo. 81501</i>		
WELL LOCATION: SEC	TOWNSHIP	RANGE
<i>32</i>	<i>5</i>	<i>S 12 W</i>
DISTANCE <i>2 1/2</i> Miles	DIRECTION <i>NE</i>	NEAREST TOWN <i>Lizana</i>
OTHER LANDMARK		
WELL PURPOSE: Home, Irrigation, Municipal, Industrial, Fish Pond, etc. <i>Home</i>		

<b>PUMP DATA</b>		
PUMP TYPE (Circle One): Submersible, Turbine, <input checked="" type="radio"/> <b>Jet</b> Flowing Well, Other (Describe) _____		
POWER TYPE (Circle One): <input checked="" type="radio"/> <b>Electric</b> , Tractor, Diesel, Gasoline, Butane, Other (Describe) _____		
Pump Capacity (GPM) <i>8</i>	No. of Stages <i>2</i>	Setting Depth  <b>FT.</b>
PUMP TEST <i>Pump not set yet</i> Well yielded _____ GPM with a drawdown of _____ ft. after _____ hours of pumping		

<b>WELL DATA</b>		
Well Depth <i>420</i>	Casing Diameter (In.) <i>2"</i>	Casing Length (Ft.) <i>410</i>
Type of Casing <i>PC</i>	Hole Depth <i>420</i>	Depth to Static Water Level <i>XP</i>
TYPE OF COMPLETION: (Circle One or More): <input checked="" type="checkbox"/> <b>Natural Development</b> , Underreamed, Telescoped, Open Hole, Other		
Top of Lap Pipe or Reduction in Casing <b>FEET</b> IF TELESKOPED OR MORE THAN ONE SCREEN: USE BACK PAGE		

<b>LOG DATA</b>	
TYPE OF LOG RUN (Circle One): Electric, Gamma Ray, Density, Sonic, <input checked="" type="radio"/> <b>No Log Run</b> , Neutron, Other (Describe) _____	
Name of Organization Running Log	

<b>SCREEN DATA</b>		
Diameter - Inches <i>2"</i>	Length - Feet <i>10</i>	Slot Size - Inches <i>.008</i>
Screen Type <i>PC WOP</i>	Depth to Bottom - Feet <i>420</i>	

<b>GEOLOGIC DATA (Office Use Only)</b>			
Surface Elev.	Geologic Unit	Unit Thickness	Depth to Top
Subs. SWL	Date	Analysis	Aquifer Test


Driller's Remarks

DESCRIPTION OF FORMATIONS ENCOUNTERED	FROM	TO
<i>Surface</i>	<i>0</i>	<i>4</i>
<i>Red Clay</i>	<i>4</i>	<i>80</i>
<i>Clay &amp; Sand Breaks</i>	<i>80</i>	<i>175</i>
<i>White Sand</i>	<i>175</i>	<i>230</i>
<i>Blue Clay</i>	<i>230</i>	<i>312</i>
<i>Sand</i>	<i>312</i>	<i>320</i>
<i>Blue Clay</i>	<i>320</i>	<i>350</i>
<i>Gray Sand</i>	<i>380</i>	<i>420 +</i>

<b>RECEIVED</b>	
<b>AUG 26 1987</b>	
Department of Natural Resources Bureau of Land & Water Resources	
IF MORE SPACE IS NEEDED, USE BACK	

If well telescopes please sketch and show depths.

GROUND LEVEL

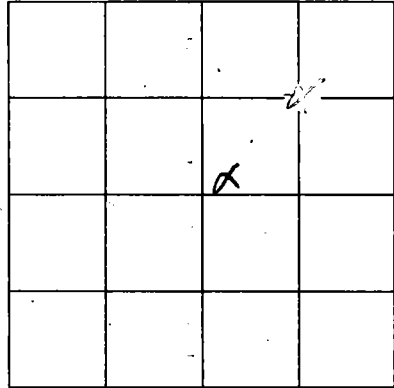

SECTION 3.2

Please indicate well location X.

ADDITIONAL INFORMATION

If more than one screen,  
show location of each on sketch.