

MISSISSIPPI DEPARTMENT OF NATURAL RESOURCES

Bureau of Land and Water Resources

Southport Mall

P.O. Box 10631

Jackson, Mississippi 39209

WATER WELL DRILLERS LOG

Harrison
3366

2-25-87
date well completed

870 Frank Price
firm name

Harrison
county well located

LANDOWNER:
Mark Lindsay
(mailing address)

description of formations encountered	from	to
Top Soil	0	3
Clay	3	100
Course Sand	160	115'

WELL LOCATION:
sec. 24 T. 5 S R. 12 W
2 miles S of Jackson
(distance) (direction) (nearest town)

WELL PURPOSE: HOME
(home, irrigation, municipal, industrial)

- WELL COMPLETION DATA:
- (1) diameter (inches) 2"
 - (2) total depth (feet) 115'
 - (3) static water level (feet) 25' below top of ground
 - (4) casing PVC, 110'
(material) (depth)
 - (size) If telescope see back.
 - (5) screen 5' length, 110' depth to top
2" PVC
(size) (material)
 - (6) pump 1 HP, 10 yield gpm
Elect (type power)
 - (7) electric log NO (yes or no)

RECEIVED

OCT 15 1987


Department of Natural Resources
Bureau of Land & Water Resources

(organization running log)
(8) how well bottom plugged
BWW

DRILLERS REMARKS:

If well telescopes please sketch and show depths.

GROUND LEVEL

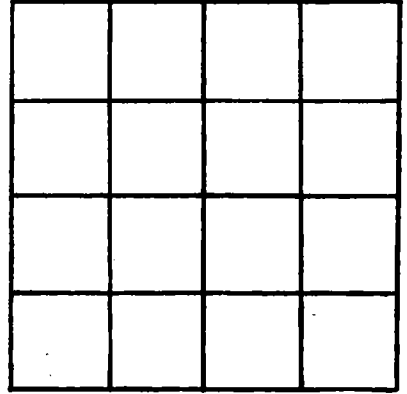

SECTION _____

Please indicate well location X.

ADDITIONAL INFORMATION

If more than one screen,
show locations of each on sketch.