

MISSISSIPPI DEPARTMENT OF NATURAL RESOURCES

Bureau of Land and Water Resources

Southport Mall

P.O. Box 10631

Jackson, Mississippi 39209

WATER WELL DRILLERS LOG

HARRISON  
B 2068

12-13 1986  
date well completed

Frank Price  
firm name

Harrison  
county well located

LANDOWNER:  
Leonel Blum  
(mailing address)

WELL LOCATION:  
sec. 14 T. 5 S. R. 12 E.  
2 miles SE of Saucho  
(distance) (direction) (nearest town)

WELL PURPOSE: HOME  
(home, irrigation, municipal, industrial)

WELL COMPLETION DATA:

(1) diameter (inches) 2"

(2) total depth (feet) 288'

(3) static water level (feet) 60' below above top of ground.

(4) casing PVC, 278'  
(material) (depth)

(size) if telescope see back.

(5) screen 10', 278'  
(length) (depth to top)

2", PVC  
(size) (material)

(6) pump 1, 8  
(HP) (yield gpm)

Elect  
(type power)

(7) electric log no  
(yes or no)

(organization running log)

(8) how well bottom plugged B W Y

| description of formations encountered | from       | to         |
|---------------------------------------|------------|------------|
| <u>Top Soil</u>                       | <u>0</u>   | <u>2</u>   |
| <u>Clay</u>                           | <u>2</u>   | <u>270</u> |
| <u>Course Sand</u>                    | <u>270</u> | <u>288</u> |

RECEIVED


OCT 15 1987

Department of Natural Resources  
Bureau of Land & Water Resources

DRILLERS REMARKS:

If well telescopes please sketch and show depths.

GROUND LEVEL

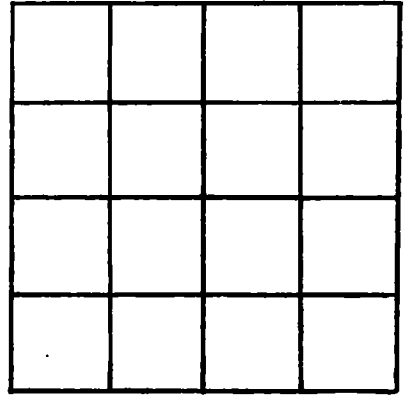

SECTION \_\_\_\_\_

Please indicate well location X.

ADDITIONAL INFORMATION

If more than one screen, show locations of each on sketch.