

MISSISSIPPI DEPARTMENT OF NATURAL RESOURCES
Bureau of Land and Water Resources

P.O. Box 10631
Jackson, Mississippi 39209
WATER WELL DRILLERS LOG

COUNTY WELL LOCATED Douglas	
WELL NUMBER B 2072	CODED
DATE WELL COMPLETED 3/5/88	

PERMIT NUMBER 0239
NAME OF DRILLING FIRM McHill Pump & Wells

NAME & MAILING ADDRESS OF LANDOWNER Barbara Copeland 14180 O'Neal rd #32 Sulfur Ms.			
WELL LOCATION:	SEC 34	TOWNSHIP 4	RANGE 12
	S	E	W
DISTANCE 2 Miles	DIRECTION North	NEAREST TOWN Sacred	
OTHER LANDMARK			
WELL PURPOSE: Home Irrigation, Municipal, Industrial, Fish Pond, etc. <input checked="" type="radio"/> Home Irrigation			

PUMP DATA		
PUMP TYPE (Circle One): <input checked="" type="radio"/> Submersible Turbine Jet Flowing Well, Other (Describe) _____		
POWER TYPE (Circle One): Electric Tractor Diesel Gasoline Butane, Other (Describe) _____		
Pump Capacity (GPM) 18	No. of Stages	Setting Depth 140' FT.
PUMP TEST		
Well yielded 18 GPM with a drawdown of 20 ft. after 1 hours of pumping		

WELL DATA		
Well Depth 280'	Casing Diameter (In.) 2" X 4"	Casing Length (Ft.) 260'
Type of Casing PVC	Hole Depth 280'	Depth to Static Water Level 95'
TYPE OF COMPLETION: (Circle One or More): <input checked="" type="radio"/> Gravel Packed <input type="radio"/> Underreamed <input type="radio"/> Telescoped, <input checked="" type="radio"/> Natural Development <input type="radio"/> Open Hole <input type="radio"/> Other		
Top of Lap Pipe or Reduction in Casing		
FEET	IF TELESCOPED OR MORE THAN ONE SCREEN: USE BACK PAGE	


LOG DATA	
TYPE OF LOG RUN (Circle One): <input checked="" type="radio"/> No Log Run, Electric, Gamma Ray, Density, Sonic, Neutron, Other (Describe) _____	
Name of Organization Running Log	

SCREEN DATA		
Diameter - Inches 2"	Length - Feet 20'	Slot Size - Inches .0006
Screen Type PVC	Depth to Bottom - Feet 280'	

GEOLOGIC DATA (Office Use Only)			
Surface Elev.	Geologic Unit	Unit Thickness	Depth to Top
Subs. SWL	Date	Analysis	Aquifer Test

Driller's Remarks

DESCRIPTION OF FORMATIONS ENCOUNTERED	FROM	TO
Mud	0	160
Sand	160	180
gravel	180	200
Sand	200	280

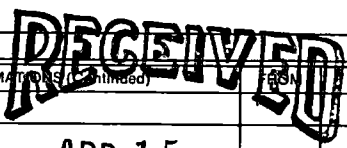

APR 15 1988

**Department of Natural Resources
Bureau of Land & Water Resources**

FORMATION (Continued)	FROM	TO


IF MORE SPACE IS NEEDED, USE BACK

If well telescopes please sketch and show depths.

PERC

uncovered

GROUND LEVEL

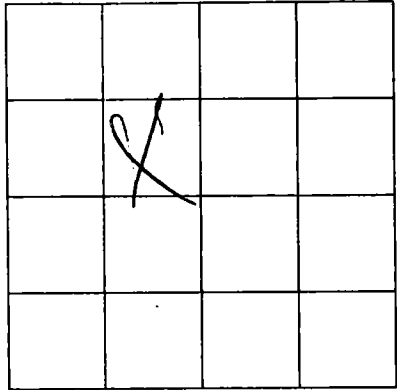

SECTION _____

Please indicate well location X.

ADDITIONAL INFORMATION

If more than one screen,
show location of each on sketch.