

**MISSISSIPPI DEPARTMENT OF NATURAL RESOURCES**  
Bureau of Land and Water Resources

P.O. Box 10631  
Jackson, Mississippi 39209  
WATER WELL DRILLERS LOG

COUNTY WELL LOCATED	<i>Harrison</i>	
WELL NUMBER	CODED	
<i>B 2080</i>		
DATE WELL COMPLETED	<i>MAY 4 89</i>	

PERMIT NUMBER	<i>0239</i>
NAME OF DRILLING FIRM	<i>McMill Pump + well</i>

NAME & MAILING ADDRESS OF LANDOWNER			
<i>A. J. Robertson</i>			
<i>New Hope Rd.</i>			
<i>Saucier rd.</i>			
WELL LOCATION:	SEC	TOWNSHIP	RANGE
	<i>6</i>	<i>5 N</i>	<i>12 W</i>
DISTANCE	DIRECTION	NEAREST TOWN	
<i>1</i> Miles	<i>East</i>	of <i>Saucier</i>	
OTHER LANDMARK			
WELL PURPOSE: <input checked="checked" type="radio"/> Home Irrigation, <input type="radio"/> Municipal, <input type="radio"/> Industrial, <input type="radio"/> Fish Pond, etc.			

PUMP DATA		
PUMP TYPE (Circle One): Submersible, Turbine, <input checked="checked" type="radio"/> Jet, Flowing Well, Other (Describe) _____		
POWER TYPE (Circle One): <input checked="checked" type="radio"/> Electric, Tractor, Diesel, Gasoline, Butane, Other (Describe) _____		
Pump Capacity (GPM)	No. of Stages	Setting Depth _____ FT.
<i>12</i>	<i>2</i>	<i>90'</i>
PUMP TEST		
Well yielded <i>20</i> GPM with a drawdown of <i>10</i> ft. after <i>1</i> hours of pumping		

WELL DATA		
Well Depth <i>260</i>	Casing Diameter (In.) <i>2"</i>	Casing Length (Ft.) <i>250</i>
Type of Casing <i>PVC</i>	Hole Depth <i>260</i>	Depth to Static Water Level <i>70'</i>
TYPE OF COMPLETION: (Circle One or More): <input checked="checked" type="checkbox"/> Gravel Packed, <input type="checkbox"/> Underreamed, <input type="checkbox"/> Telescoped, <input checked="checked" type="checkbox"/> Natural Development, <input type="checkbox"/> Open Hole, <input type="checkbox"/> Other (Describe) _____		
Top of Lap Pipe or Reduction in Casing  FEET      IF TELESOPED OR MORE THAN ONE SCREEN: USE BACK PAGE		

LOG DATA	
TYPE OF LOG RUN (Circle One): No Log Run, Electric, Gamma Ray, Density, Sonic, Neutron, Other (Describe) _____	
Name of Organization Running Log _____	

SCREEN DATA		
Diameter - Inches <i>2"</i>	Length - Feet <i>10'</i>	Slot Size - Inches <i>.0006</i>
Screen Type <i>PVC</i>	Depth to Bottom - Feet <i>260'</i>	


GEOLOGIC DATA (Office Use Only)			
Surface Elev.	Geologic Unit	Unit Thickness	Depth to Top
Subs. SWL	Date	Analysis	Aquifer Test

Driller's Remarks

DESCRIPTION OF FORMATIONS ENCOUNTERED	FROM	TO	FORMATION IDENTIFICATION
<i>Mud</i>	<i>0</i>	<i>80</i>	<b>RECEIVED</b> MAY 24 1989  Department of Natural Resources Bureau of Land & Water Resources
<i>Sand</i>	<i>20</i>	<i>60</i>	
<i>Mud</i>	<i>60</i>	<i>220</i>	
<i>Sand</i>	<i>220</i>	<i>260</i>	
IF MORE SPACE IS NEEDED, USE BACK			

If well telescopes please sketch and show depths.

GROUND LEVEL

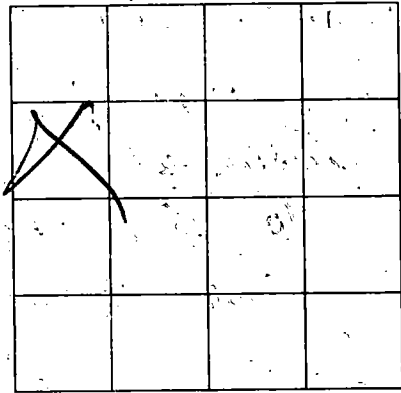

SECTION \_\_\_\_\_

Please indicate well location X.

ADDITIONAL INFORMATION

If more than one screen,  
show location of each on sketch.