

MISSISSIPPI DEPARTMENT OF NATURAL RESOURCES

Bureau of Land and Water Resources

P.O. Box 10631

Jackson, Mississippi 39209

WATER WELL DRILLERS LOG

COUNTY WELL LOCATED <i>Garrison</i>	
WELL NUMBER <i>3 288</i>	CODED
DATE WELL COMPLETED <i>Oct 4-89</i>	

PERMIT NUMBER <i>0239</i>
NAME OF DRILLING FIRM <i>Metall Pump & Wells</i>

NAME & MAILING ADDRESS OF LANDOWNER <i>Charles Glabe</i>			
WELL LOCATION: SEC TOWNSHIP RANGE <i>25 5 N 12 E</i>			
DISTANCE <i>4</i> Miles	DIRECTION <i>South</i> of	NEAREST TOWN <i>Snucier</i>	
OTHER LANDMARK			
WELL PURPOSE: <input checked="" type="checkbox"/> Home Irrigation, <input type="checkbox"/> Municipal, <input type="checkbox"/> Industrial, <input type="checkbox"/> Fish Pond, etc.			

PUMP DATA		
PUMP TYPE (Circle One): Submersible, Turbine, <input checked="" type="checkbox"/> Jet, Flowing Well, Other (Describe) _____		
POWER TYPE (Circle One): <input checked="" type="checkbox"/> Electric, Tractor, Diesel, Gasoline, Butane, Other (Describe) _____ H/P _____		
Pump Capacity (GPM) <i>8</i>	No. of Stages <i>2</i>	Setting Depth <i>100'</i> FT.
PUMP TEST		
Well yielded <i>8</i> GPM with a drawdown of <i>10</i> ft. after <i>1</i> hours of pumping		

WELL DATA		
Well Depth <i>350'</i>	Casing Diameter (In.) <i>2"</i>	Casing Length (Ft.) <i>20'</i>
Type of Casing <i>PVC</i>	Hole Depth <i>360'</i>	Depth to Static Water Level <i>70'</i>
TYPE OF COMPLETION: (Circle One or More): <input checked="" type="checkbox"/> Gravel Packed, <input checked="" type="checkbox"/> Underreamed, <input type="checkbox"/> Telescoped, <input checked="" type="checkbox"/> Natural Development, <input type="checkbox"/> Open Hole, <input type="checkbox"/> Other (Describe) _____		
Top of Lap Pipe or Reduction in Casing FEET IF TELESCOPED OR MORE THAN ONE SCREEN: USE BACK PAGE		

LOG DATA	
TYPE OF LOG RUN (Circle One): Electric, Gamma Ray, Density, Sonic, Neutron, <input checked="" type="checkbox"/> No Log Run, Other (Describe) _____	
Name of Organization Running Log	

SCREEN DATA		
Diameter - Inches <i>2"</i>	Length - Feet <i>10'</i>	Slot Size - Inches <i>0006</i>
Screen Type <i>PVC</i>	Depth to Bottom - Feet <i>350'</i>	

GEOLOGIC DATA (Office Use Only)			
Surface Elev.	Geologic Unit	Unit Thickness	Depth to Top
Subs. SWL	Date	Analysis	Aquifer Test


Driller's Remarks

DESCRIPTION OF FORMATIONS ENCOUNTERED	FROM:	TO	FORMATIONS (Continued)	FROM	TO
<i>mud</i>	<i>0</i>	<i>120</i>	RECEIVED AUG 16 1990 Department of Natural Resources Bureau of Land & Water Resources		
<i>sand</i>	<i>120</i>	<i>140</i>			
<i>mud</i>	<i>140</i>	<i>230</i>			
<i>sand</i>	<i>230</i>	<i>260</i>			
<i>mud</i>	<i>260</i>	<i>310</i>			
<i>sand</i>	<i>310</i>	<i>350</i>			

IF MORE SPACE IS NEEDED, USE BACK

If well telescopes please sketch and show depths.

GROUND LEVEL

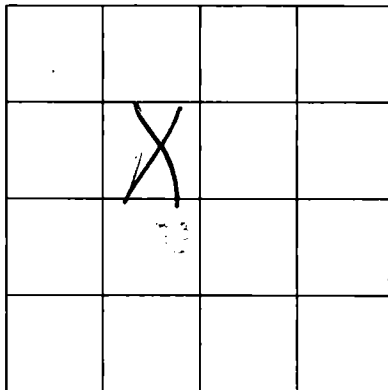

SECTION _____

Please indicate well location X.

ADDITIONAL INFORMATION

If more than one screen,
show location of each on sketch.