

MISSISSIPPI DEPARTMENT OF NATURAL RESOURCES

Bureau of Land and Water Resources

P.O. Box 10631

Jackson, Mississippi 39209

WATER WELL DRILLERS LOG

COUNTY WELL LOCATED Harrison	
WELL NUMBER B 293	CODED
DATE WELL COMPLETED 4-25-90	

PERMIT NUMBER 0-519
NAME OF DRILLING FIRM Walker's Well Service

NAME & MAILING ADDRESS OF LANDOWNER Jeff Cressioni Coast Nursery Saucer, Ms.		
WELL LOCATION: SEC	TOWNSHIP	RANGE
22	5	18 E
DISTANCE	DIRECTION	NEAREST TOWN
2 Miles	South	Hwy 49
OTHER LANDMARK Saucer Lyman Rd		
WELL PURPOSE: Home, Irrigation, Municipal, Industrial, Fish Pond, etc.		

PUMP DATA		
PUMP TYPE (Circle One): Submersible Turbine, Jet, Flowing Well, Other (Describe) _____		
POWER TYPE (Circle One): Electric , Tractor, Diesel, Gasoline, Butane, Other (Describe) _____ H/P _____		
Pump Capacity (GPM) 50	No. of Stages 17	Setting Depth 200 FT.
PUMP TEST		
Well yielded _____ GPM with a drawdown of _____ ft. after _____ hours of pumping		

WELL DATA		
Well Depth 350	Casing Diameter (In.) 4	Casing Length (Ft.) 330
Type of Casing PVC	Hole Depth 350	Depth to Static Water Level 80
TYPE OF COMPLETION: (Circle One or More): Gravel Packed, Underreamed, Telescoped, Natural Development , Open Hole, Other		
Top of Lap Pipe or Reduction in Casing FEET IF TELESCOPED OR MORE THAN ONE SCREEN: USE BACK PAGE		

LOG DATA	
TYPE OF LOG RUN (Circle One): No Log Run, Electric, Gamma Ray, Density, Sonic, Neutron, Other (Describe) _____	
Name of Organization Running Log	

SCREEN DATA		
Diameter - Inches 4	Length - Feet 20	Slot Size - Inches #12
Screen Type Slot	Depth to Bottom - Feet 350	


GEOLOGIC DATA (Office Use Only)			
Surface Elev.	Geologic Unit	Unit Thickness	Depth to Top
Subs. SWL	Date	Analysis	Aquifer Test
Driller's Remarks			

DESCRIPTION OF FORMATIONS ENCOUNTERED	FROM	TO
white clay	0	15
red clay	15	35
sand	35	50
blue clay	50	180
sand fine	180	216
blue clay	216	300
sand	300	325
rocks	325	350

FORMATIONS (Continued)	FROM	TO
RECEIVED		
MAY 25 1990		
Department of Natural Resources Bureau of Land & Water Resources		
IF MORE SPACE IS NEEDED, USE BACK		

If well telescopes please sketch and show depths.

GROUND LEVEL

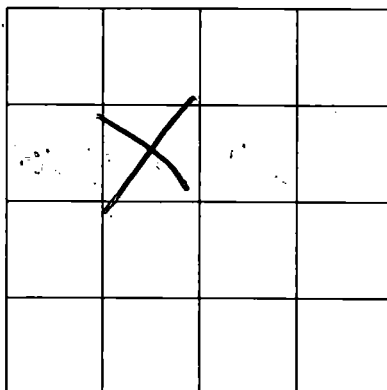

SECTION _____

Please indicate well location X.

ADDITIONAL INFORMATION

If more than one screen,
show location of each on sketch.