

MISSISSIPPI DEPARTMENT OF NATURAL RESOURCES
Bureau of Land and Water Resources

P.O. Box 10631
Jackson, Mississippi 39209
WATER WELL DRILLERS LOG

COUNTY WELL LOCATED HARRISON	
WELL NUMBER B 2915	CODED
DATE WELL COMPLETED 6-26-90	

PERMIT NUMBER 0239
NAME OF DRILLING FIRM McNeil

NAME & MAILING ADDRESS OF LANDOWNER Mr. Reddock		
Styles rd.		
Gulfport, Ms. 39505		
WELL LOCATION: SEC	TOWNSHIP	RANGE
3	5	12 <small>(W)</small>
DISTANCE	DIRECTION	NEAREST TOWN
8 Miles	West	Snider
OTHER LANDMARK Shaw road		
WELL PURPOSE: <input type="checkbox"/> Home, <input type="checkbox"/> Irrigation, <input type="checkbox"/> Municipal, <input type="checkbox"/> Industrial, <input type="checkbox"/> Fish Pond, etc.		

PUMP DATA		
PUMP TYPE (Circle One): Submersible, Turbine, Jet Flowing Well, Other (Describe) _____		
POWER TYPE (Circle One): Electric , Tractor, Diesel, Gasoline, Butane, Other (Describe) _____ H/P _____		
Pump Capacity (GPM) 15	No. of Stages 2	Setting Depth 110' FT.
PUMP TEST		
Well yielded 8 GPM with a drawdown of 5 ft. after 1 hours of pumping		

WELL DATA		
Well Depth 400'	Casing Diameter (In.) 2"	Casing Length (Ft.) 390'
Type of Casing PVC	Hole Depth 400'	Depth to Static Water Level 90'
TYPE OF COMPLETION: (Circle One or More): Gravel Packed , Underreamed, Telescoped, Natural Development , Open Hole, Other		
Top of Lap Pipe or Reduction in Casing FEET IF TELESCOPED OR MORE THAN ONE SCREEN: USE BACK PAGE		

LOG DATA	
TYPE OF LOG RUN (Circle One): Electric , Gamma Ray, Density, Sonic, Neutron, Other (Describe) _____ No Log Run	
Name of Organization Running Log	

SCREEN DATA		
Diameter - Inches 2"	Length - Feet 10	Slot Size - Inches .0006
Screen Type Sch 40 pvc	Depth to Bottom - Feet 400'	

GEOLOGIC DATA (Office Use Only)			
Surface Elev.	Geologic Unit	Unit Thickness	Depth to Top
Subs. SWL	Date	Analysis	Aquifer Test

Driller's Remarks


DESCRIPTION OF FORMATIONS ENCOUNTERED	FROM	TO	FOR	TO
SAND, MUD	0	20		
SAND	20	40		
SAND, MUD	40	60		
MUD	60	80		
SAND	80	120		
SAND - MUD	120	140		
MUD	140	200		
SAND	200	240		
MUD	240	340		
SAND	340	400		

RECEIVED
SEP 23 1991
Dept. of Environmental Quality
Bureau of Land & Water Resources

IF MORE SPACE IS NEEDED, USE BACK

If well telescopes please sketch and show depths.

GROUND LEVEL

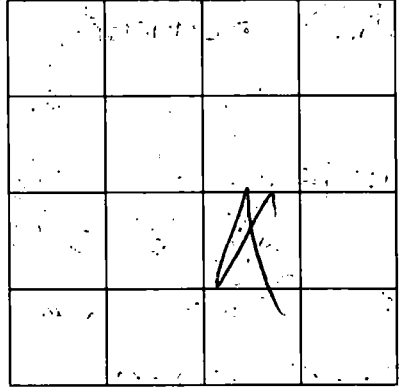

SECTION _____

Please indicate well location X.

ADDITIONAL INFORMATION

Multiple horizontal lines for writing additional information.

DEVELOPER

If more than one screen, show location of each on sketch.