

**MISSISSIPPI DEPARTMENT OF NATURAL RESOURCES**  
Bureau of Land and Water Resources

P.O. Box 10631  
Jackson, Mississippi 39209  
**WATER WELL DRILLERS LOG**

COUNTY WELL LOCATED <i>HARRISON</i>	
WELL NUMBER <i>B 2004</i>	CODES
DATE WELL COMPLETED <i>3/12/93</i>	

PERMIT NUMBER
NAME OF DRILLING FIRM <i>MEB DRILLING Co.</i>

NAME & MAILING ADDRESS OF LANDOWNER <i>ROBERT DOTILLA</i> <i>22161 ROAD 209</i> <i>SAUCIER, MS. 39574</i>		
WELL LOCATION: SEC	TOWNSHIP	RANGE
<i>32</i>	<i>5 N</i>	<i>12 W</i>
DISTANCE <i>2</i> Miles	DIRECTION <i>N</i>	NEAREST TOWN <i>Lizana</i>
OTHER LANDMARK		
WELL PURPOSE: Home, Irrigation, Municipal, Industrial, Fish Pond, etc. <i>Home</i>		

PUMP DATA		
PUMP TYPE (Circle One): Submersible, Turbine, <u>Jet</u> Flowing Well, Other (Describe) _____		
POWER TYPE (Circle One): <u>Electric</u> Tractor, Diesel, Gasoline, Butane, Other (Describe) _____ H/P <u>1</u>		
Pump Capacity (GPM) <i>10</i>	No. of Stages <i>2</i>	Setting Depth <i>60</i> FT.
PUMP TEST		
Well yielded _____ GPM with a drawdown of _____ ft. after _____ hours of pumping		

WELL DATA		
Well Depth <i>130'</i>	Casing Diameter (In.) <i>2"</i>	Casing Length (Fl.) <i>100</i>
Type of Casing <i>PRC</i>	Hole Depth <i>130</i>	Depth to Static Water Level <i>42</i>
TYPE OF COMPLETION: (Circle One or More): <u>Gravel Packed</u> , Underreamed, Telescoped, <u>Natural Development</u> , Open Hole, Other		
Top of Lap Pipe or Reduction in Casing FEET IF TELESCOPED OR MORE THAN ONE SCREEN: USE BACK PAGE		

LOG DATA	
TYPE OF LOG RUN (Circle One): Electric, Gamma Ray, Density, Sonic, Neutron, Other (Describe) _____ <u>No Log Run</u>	
Name of Organization Running Log	

SCREEN DATA		
Diameter - Inches <i>2</i>	Length - Feet <i>10</i>	Slot Size - Inches <i>1008</i>
Screen Type <i>PRC-5/16th</i>	Depth to Bottom - Feet <i>110</i>	

GEOLOGIC DATA (Office Use Only)			
Surface Elev.	Geologic Unit	Unit Thickness	Depth to Top
Subs. SWL	Date	Analysis	Aquifer Test

Driller's Remarks <i>20ft - 2" Tailpipe</i>
--


DESCRIPTION OF FORMATIONS ENCOUNTERED	FROM	TO
<i>Sand</i>	<i>0</i>	<i>50</i>
<i>Red Clay</i>	<i>50</i>	<i>60</i>
<i>White Clay</i>	<i>60</i>	<i>95</i>
<i>White Sand</i>	<i>95</i>	<i>110</i>
<i>Blue Clay</i>	<i>110</i>	<i>130</i>

FORMATIONS (Continued)	FROM	TO
<b>RECEIVED</b>		
<b>MAR 24 1993</b>		
Dept. of Environmental Quality Office of Land & Water Resources		

IF MORE SPACE IS NEEDED, USE BACK

If well telescopes please sketch and show depths.

GROUND LEVEL

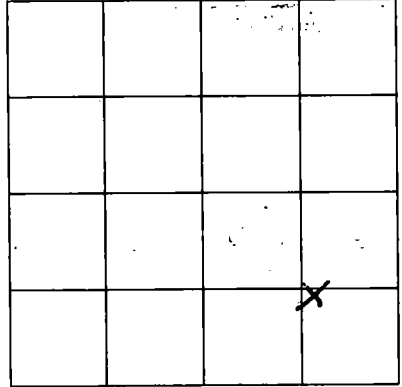

SECTION 32

Please indicate well location X.

ADDITIONAL INFORMATION

If more than one screen,  
show location of each on sketch.