

MISSISSIPPI DEPARTMENT OF NATURAL RESOURCES
Bureau of Land and Water Resources
 Southport Mall
 P.O. Box 10631
 Jackson, Mississippi 39209
WATER WELL DRILLERS LOG

Harrison
~~11/20/81~~
C

11/20/81 19 Lyman Well Co. Harrison
 date well completed firm name county well located

LANDOWNER: Harvey Sherman
Rt. 10, Hwy 49
Spt, Md
 (mailing address)

description of formations encountered	from	to
<u>Red Sand</u>	<u>0</u>	<u>80</u>
<u>Blue gum clay</u>	<u>80</u>	<u>115</u>
<u>good sand</u>	<u>115</u>	<u>145</u>

WELL LOCATION:
 sec 33 T 5 N R 10 E
14 miles N of Spt
 (distance) (direction) (nearest town)

WELL PURPOSE: car lot
 (home, irrigation, municipal, industrial)

- WELL COMPLETION DATA:**
- (1) diameter (inches) 2"
 - (2) total depth (feet) 145'
 - (3) static water level (feet) 19 below above top of ground.
 - (4) casing PVC, 135'
 (material) (depth)
2" If telescope see back.
 (size)
 - (5) screen 10', 135'
 (length) (depth to top)
2", PVC
 (size) (material)
 - (6) pump 1, 15
 (HP) (yield gpm)
electric
 (type power)
 - (7) electric log NO
 (yes or no)
NO
 (organization running log)
 - (8) how well bottom plugged sand
shark.

DRILLERS REMARKS:


DEPT. OF NATURAL RESOURCES
 BUREAU OF LAND & WATER RESOURCES

APR 22 1982

RECEIVED

If well telescopes please sketch and show depths.

GROUND LEVEL

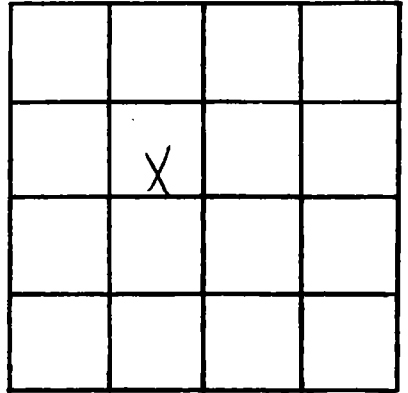

SECTION 33

Please indicate well location X.

ADDITIONAL INFORMATION

If more than one screen,
show locations of each on sketch.