

HARRISON
 C 58
 3-68
 WSGS
 3-15-68
 date well completed

MISSISSIPPI
 BOARD OF WATER COMMISSIONERS
 416 North State Street
 Jackson, Mississippi 39201

WATER WELL DRILLERS LOG

CODED

M & B Drilling Co.
 firm name

Harrison
 county well located

LANDOWNER:
 John Allison, Jr.
 Rt. 1 Saucier, Miss.
 (mailing address)


WELL LOCATION:
 sec. 19 T 5 S R 11 W
 3 miles S of Saucier
 (distance) (direction) (nearest town)

WELL PURPOSE: Home & Store
 (home, irrigation, municipal, industrial)

WELL COMPLETION DATA:

(1) diameter (inches) 4 X 2
 (2) total depth (feet) 708
 (3) static water level (feet) 34 below top of ground.
 (4) casing PVC 708 (material) (depth)
 (size) if telescope see back.
 (5) screen 10 668 (length) (depth to top)
 2" PVC Sand Pac (size) (material)
 (6) pump 1 20 (HP) (yield gpm)
 220V 1/2 Submersible (type power) (brand)
 (7) electric log Yes (yes or no)
 U.S. G.S. (organization running log)
 (8) how well bottom plugged PVC Cap

description of formations encountered	from	to
Surface Clay	0	12
Sand	12	23
Purple Clay	23	33
Brown Sand	33	37
White Clay	37	55
Brown White Clay & Rusty Iron	55	65
Soft Dark Grey Clay	65	85
Fine Sand & light Grey Clay	85	100
Blue Clay	100	140
Sand & Clay Breaks	140	157
Blue Clay	157	230
Sand & Clay Breaks	230	240
Blue Clay	240	280
Sand	280	310
Sand & Black Gravel	310	357
Coarse Rust on inside of Baker pipes Gravel		
Blue Clay	357	430
Sand	430	435
Blue Clay	435	465
Limestone	465	470
Blue Clay	470	520
Fine Sand Blue Clay & Sea Shells	520	570
Blue Clay	570	650
Sand	650	660
Clay	660	680
Sand	680	693
Blue Clay	693	708
		+
		810
		600

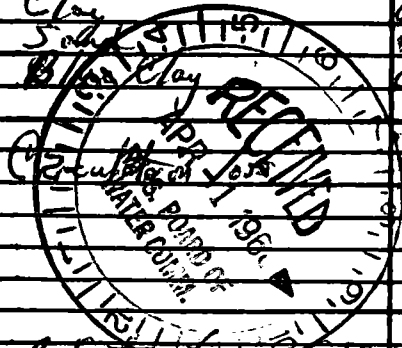

DRILLERS REMARKS:
 Water at 280-337 Very Rusty. This reason for new & deep well.
 Do 8 wells like this in this area.

Refer to log for Self-Probe Band August 67-
 One well here 5 years (Faye Allison) rust still good, but a little.

