

HAR.

MISSISSIPPI BOARD OF WATER COMMISSIONERS

C28

CODED

9-18-60

WATER WELL DRILLERS LOG

Date: Sept 18, 1960, Driller: Joe Miller County Harrison
(Name)

(1) Owner of Land: Mr. Jones
(Name)
RR # 1 success
(Address)

(2) Location: SW 1/4, NE 1/4, Sec. 31 T5S R11W
15 miles North, of Sulfur
(distance) (direction) (Nearest Town)

(3) Topography: Hilly
(Hilly) (Flat) (Level)

(4) Purpose of Well: Home
(Domestic Irrigation
Municipal, Industrial, Other)

Description & Color of Materials Sand, Clay, Red Clay, Shell, etc.	Thick- ness Feet	Depth Feet
<u>Surface</u>		<u>5</u>
<u>Red Sand</u>	<u>5</u>	<u>10</u>
<u>Fine Sand</u>	<u>12</u>	<u>22</u>
<u>White Clay</u>	<u>25</u>	<u>47</u>
<u>Small Brack.</u>	<u>5</u>	<u>52</u>
<u>Wh. Clay + Blue Cl.</u>	<u>21</u>	<u>73</u>
<u>Blue Clay</u>	<u>199</u>	<u>272</u>
<u>Brack.</u>	<u>8</u>	<u>280</u>
<u>Fine Gray Sand</u>	<u>12</u>	<u>292</u>
<u>" " "</u>	<u>11</u>	<u>303</u>
<u>Coarse " "</u>	<u>11</u>	<u>314</u>
<u>Small Lbk. Brack</u>	<u>36</u>	<u>350</u>
<u>+ White. Gray Sand</u>		

Information upon completion of well:

(1) Diameter 2 inches.

(2) Total Depth 350 feet.

(3) Water Level 50' feet below top of ground.
340'


(4) Cased to Top Stream, Size 2

(5) Screen: Size 2" x 10, Length 10'

(6) Were any formations sealed against pollution?
_____ yes, _____ no.

Still in
Coarse Sand
+ Small Brack.

CODED

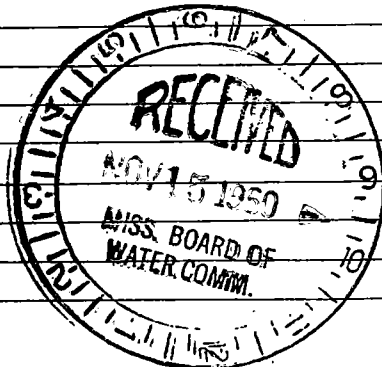

(Use Back Side)

Well No.

1
□
Anderson St
□

□
↓
Jones

Desola Park

Bay Park
Park

05.19

S