

MISSISSIPPI
BOARD OF WATER COMMISSIONERS
416 North State Street
Jackson, Mississippi 39201

CODED

WATER WELL DRILLERS LOG

5/16/71 Coastal Drilling Co. Harrison
date well completed firm name county well located

LANDOWNER L. J. Angelo
Donald R. G
Saucus, Miss
(mailing address)

description of formations encountered	from	to
<u>Top Soil</u>	<u>6</u>	<u>5</u>
<u>White Sand</u>	<u>5</u>	<u>15</u>
<u>Blue Clay</u>	<u>15</u>	<u>205</u>
<u>fine white sand</u>	<u>205</u>	<u>236</u>
<u>Coarse white sand</u>	<u>236</u>	<u>269</u>

WELL LOCATION:
sec. 17 T. 5 N. R. 11 E.
2 miles SE of Saucus
(distance) (direction) (nearest town)

WELL PURPOSE: Home
(home, irrigation, municipal, industrial)

- WELL COMPLETION DATA:
- (1) diameter (inches) 2"
 - (2) total depth (feet) 209
 - (3) static water level (feet) 32 below top of ground.
 - (4) casing glu. 259
(material) (depth)
(size) If telescope see back.
 - (5) screen 10' 259
(length) (depth to top)
2" SS
(size) (material)
 - (6) pump One 17
(HP) (yield gpm)
Ele
(type power)
 - (7) electric log No
(yes or no)
(organization running log)

CODED

(8) how well bottom plugged
2 foot mud valve


DRILLERS REMARKS:
None

MAY 18 1971

MISS. BD. OF
WATER COM.

If well telescopes please sketch and show depths.

GROUND LEVEL

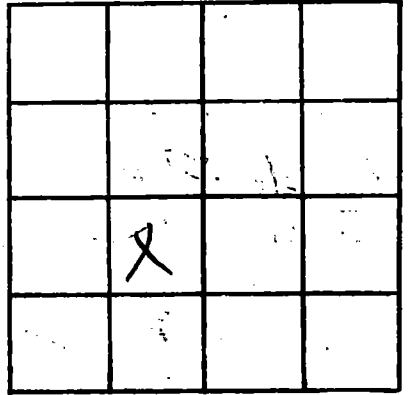

SECTION _____

Please indicate well location X.

ADDITIONAL INFORMATION

If more than one screen, show locations of each on sketch.