

MISSISSIPPI BOARD OF WATER COMMISSIONERS

CODED

31
6-10-62

WATER WELL DRILLERS LOG

Date: June 10, 1962, Driller: Joe Miller County Harrison
(Name)

(1) Owner of Land: John Allston
(Name)
Rt 1 Sallis Miss
(Address)

(2) Location: SW 1/4, SW 1/4, Sec. 20 T. 52R. 11E
4 miles Southeast of Sallis
(distance) (direction) (Nearest Town)

(3) Topography: Hilly
(Hilly) (Flat) (Level)

(4) Purpose of Well: Domestic
(Domestic Irrigation
Municipal, Industrial, Other)

Description & Color of Materials Sand, Clay, Red Clay, Shell, etc.	Thick- ness Feet	Depth Feet
Surface	5	5
Red Clay + Brown Cl.	43	48
Blue Clay	67	115
Light Sand (Coarse)	3	118
Blue Clay Hard	7	125
Sand, Fatty	12	137
Sand, Grady	16	153
Fine Sand		
Clay, Blue	2	155

Information upon completion of well:

(1) Diameter 2" inches.

(2) Total Depth 155' feet.

(3) Water Level 27' feet below top of ground.

(4) Cased to 143', Size 2"

(5) Screen: Size 2", Length 10'


(6) Were any formations sealed against pollution?
_____ yes, _____ no.

If YES depth of formation _____

Why _____

Drillers Remarks: _____

CODED

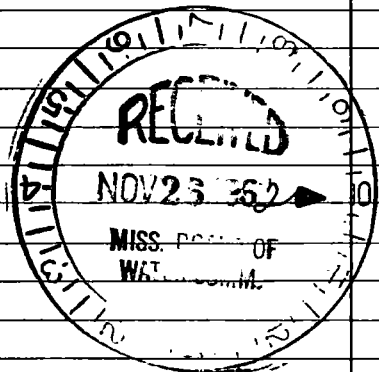

(Use Back Side)

Well No.

Lower

Alton
Alton



Alton Weir

Beag Bait's Lane

