

HAR.
C 32
8-25-62

WATER WELL DRILLERS LOG

CODED

Date: Aug 25, 1962, Driller: Joe Miller County Harrison
(Name)

| (1) Owner of Land: | Description & Color of Materials Sand, Clay, Red Clay, Shell, etc. | Thick- ness Feet | Depth Feet |
|---|---|------------------------|---------------|
| <u>H H Bond</u> (Name) | <u>Surface</u> | <u>8</u> | <u>8</u> |
| <u>RR #1 Sauer Mess</u> <u>Box 196</u> (Address) | <u>Sand & Gravel</u> | <u>8</u> | <u>16</u> |
| (2) Location: <u>NE 1/4, SE 1/4, Sec. 7 T5R11W</u> | <u>Blue Clay</u> | <u>204</u> | <u>220</u> |
| <u>4</u> miles <u>East</u> of <u>Sauer</u> (distance) (direction) (Nearest Town) | <u>Gravelly Fine</u> | <u>30</u> | <u>250</u> |
| (3) Topography: <u>Hilly</u> (Hilly) (Flat) (Level) | <u>Sandy and Coarse</u> | <u>24</u> | <u>274</u> |
| (4) Purpose of Well: <u>Domestic</u> (Domestic Irrigation Municipal, Industrial, Other) | <u>Hard sand (Finer)</u> | <u>10</u> | <u>284</u> |


Information upon completion of well:

- (1) Diameter 2" inches.
- (2) Total Depth 284' feet.
- (3) Water Level 27' feet below top of ground.
- (4) Cased to 264', Size 2"
- (5) Screen: Size 2", Length 10'
- (6) Were any formations sealed against pollution?
_____ yes, _____ no.

If YES depth of formation _____
Why _____

Drillers Remarks: _____

CODED

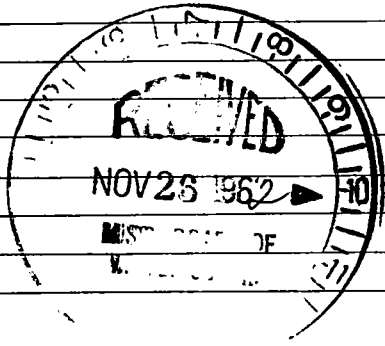

(Use Back Side)

Well No.

[Faint, illegible handwritten text at the top of the page]

[Faint, illegible handwritten text in the upper left quadrant]

Down

67

15th & 149

London

