

HAR.
C 33
10-62

MISSISSIPPI BOARD OF WATER COMMISSIONERS

WATER WELL DRILLERS LOG

CODED

Date: Feb, 1962, Driller: Joe Miller County: Tarrison
(Name)

(1) Owner of Land: John Allison
(Name)
RR# 1 Louis Miss
(Address)

(2) Location: NW 1/4, S. 1 1/4, Sec. 30 T. 11 N
15 miles North of Suffolk
(distance) (direction) (Nearest Town)

(3) Topography: Hilly
(Hilly) (Flat) (Level)

(4) Purpose of Well: Domestic
(Domestic Irrigation
Municipal, Industrial, Other)

Description & Color of Materials Sand, Clay, Red Clay, Shell, etc.	Thick- ness Feet	Depth Feet
<u>Surface</u>	<u>12</u>	<u>12</u>
<u>Red Clay w/ Sh. Clay</u>	<u>48</u>	<u>60</u>
<u>Blue Clay</u>	<u>70</u>	<u>130</u>
<u>Sand. Med. Fine</u>	<u>6'</u>	<u>136</u>
<u>Blue Clay</u>	<u>144</u>	<u>280</u>
<u>Med Sand (Fine)</u>	<u>15</u>	<u>295</u>
<u>Med Sand. (Med)</u>	<u>19</u>	<u>314</u>
<u>Sand soft clay. NG</u>	<u>4</u>	<u>318</u>
<u>Red Blue Clay</u>	<u>3'</u>	<u>321</u>
<u>Wat. 7" Gal Pipe</u>		

Information upon completion of well:

(1) Diameter 2" inches.

(2) Total Depth 321' feet.

(3) Water Level 31' feet below top of ground.

(4) Cased to 304, Size 2"

(5) Screen: Size 2", Length 10'


(6) Were any formations sealed against pollution?
_____ yes, _____ no.

If YES depth of formation _____

Why _____

Drillers Remarks: _____

CODED

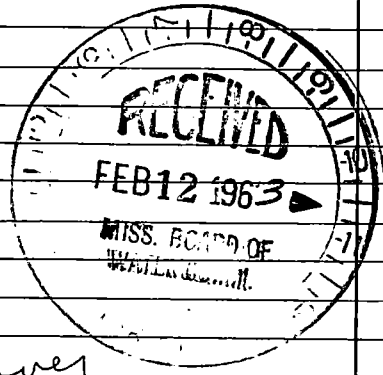

over

(Use Back Side)

Well No.

Hwy 49

Old Hwy.

• well

Big Pelon River

N
↓

2000

2000

