


HAR. 34  
C 10-1-62

WATER WELL DRILLERS LOG

Date: 10-1, 1962, Driller: C. T. SWITZER WELL CO. County Harrison

(Name)

(1) Owner of Land: _____ (Name)	Description & Color of Materials Sand, Clay, Red Clay, Shell, etc.	Thick- ness Feet	Depth Feet
<u>Laurel Baptist Mission</u>	<u>Clay</u>	<u>00</u>	<u>20</u>
<u>Highway 19, Laurel</u>	<u>Sand, fine red</u>	<u>20</u>	<u>40</u>
(2) Location: _____ 1/4, _____ 1/4, Sec. _____ T. _____ R. _____	<u>Clay</u>	<u>60</u>	<u>100</u>
_____ miles _____ of _____	<u>Clay, 3 rocks</u>	<u>100</u>	<u>210</u>
(distance) (direction) (Nearest Town)	<u>Sand, fine</u>	<u>210</u>	<u>220</u>
(3) Topography: _____	<u>Sand, fine</u>	<u>220</u>	<u>250</u>
(Hilly) (Flat) (Level)			
(4) Purpose of Well: <u>Church</u>			
(Domestic Irrigation Municipal, Industrial, Other)			
Information upon completion of well:			
(1) Diameter <u>2</u> inches.			
(2) Total Depth <u>250</u> feet.			
(3) Water Level <u>70'</u> feet below top of ground.			
(4) Cased to <u>250'</u> , Size <u>2"</u>			
(5) Screen: Size <u>2"</u> , Length <u>10'</u>			
(6) Were any formations sealed against pollution?			
<u>yes</u> , _____ no.			
If YES depth of formation _____			
Why <u>health department requirement</u>			
Drillers Remarks: _____			
_____			
_____			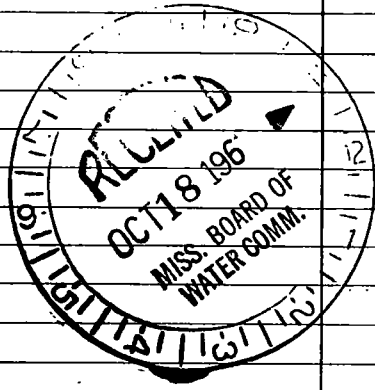
(Use Back Side)

Well No.

