

C35  
11-2-62

WATER WELL DRILLERS LOG

**CODED**

Date: Nov. 2, 1962, Driller: M & B Drilling Co. County Harrison  
(Name)

(1) Owner of Land: Nennis Broadus  
(Name)  
P.R. Sancier, Miss.  
(Address)

(2) Location: NW 1/4, SW 1/4, Sec. 32 T45R11W  
2 miles NE of Sancier  
(distance) (direction) (Nearest Town)

(3) Topography: Hilly  
(Hilly) (Flat) (Level)

(4) Purpose of Well: Domestic  
(Domestic Irrigation  
Municipal, Industrial, Other)

Description & Color of Materials Sand, Clay, Red Clay, Shell, etc.	Thick- ness Feet	Depth Feet
<u>Red Clay</u>	<u>33</u>	<u>33</u>
<u>Blue Clay</u>	<u>60</u>	<u>93</u>
<u>Sand Blebs &amp; etc</u>	<u>5</u>	<u>98</u>
<u>Blue clay</u>	<u>57</u>	<u>155</u>
<u>Grey Sand</u>	<u>22</u>	<u>177</u>
<u>Brownish-Red Sand</u>	<u>63</u>	<u>240</u>
<u>Blue Clay</u>	<u>2</u>	<u>242</u>
<u>Grey Sand</u>	<u>20</u>	<u>262</u>
<u>Blue Clay</u>	<u>262-280</u>	<u>ca?</u>

Information upon completion of well:

(1) Diameter 2 inches.

(2) Total Depth 258 feet.

(3) Water Level 31 feet below top of ground.

(4) Cased to 252, Size 2"

(5) Screen: Size 8 1/2", Length 6 FT


(6) Were any formations sealed against pollution?  
\_\_\_\_\_ yes, \_\_\_\_\_ no.

**CODED**

If YES depth of formation \_\_\_\_\_

Why \_\_\_\_\_

Drillers Remarks: \_\_\_\_\_

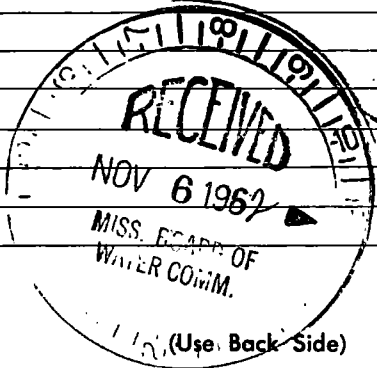

Well No.

1949

Handwritten notes and a grid on the left side of the page. The grid is approximately 10 columns wide and 15 rows high. The notes are scattered across the page, with some appearing to be a list or series of entries.

1949

Handwritten notes and a grid on the bottom half of the page. The grid is approximately 10 columns wide and 15 rows high. The notes are scattered across the page, with some appearing to be a list or series of entries.