

HARRISON  
C 37  
5-11-71

MISSISSIPPI  
 BOARD OF WATER COMMISSIONERS  
 416 North State Street  
 Jackson, Mississippi 39201

**CODED**

WATER WELL DRILLERS LOG

5-11 1971 Parnell Anderson Harrison  
 date well completed firm name county well located

LANDOWNER: Mega Berbet  
Lyman  
 (mailing address)

WELL LOCATION:  
 sec. 26 T. 5 S. R. 11  
6 miles N of Lyman  
 (distance) (direction) (nearest town)

WELL PURPOSE: Home  
 (home, irrigation, municipal, industrial)

WELL COMPLETION DATA:

(1) diameter (inches) 2"

(2) total depth (feet) 147'

(3) static water level (feet) 55' below above top of ground.

(4) casing Plastic, 142'  
 (material) (depth)

(size) if telescope see back.

(5) screen 5', 142'  
 (length) (depth to top)

2', Plastic  
 (size) (material)

(6) pump 1 8  
 (HP) (yield gpm)

Electric  
 (type power)

(7) electric log no  
 (yes or no)

(organization running log)

(8) how well bottom plugged Backwash Valve

description of formations encountered	from	to
Top Soil	0	6'
Pink Clay	6	14
White Clay	14	33
Blue Clay	33	78
Top Sand	78	105
Blue Clay	105	130
Coarse sand	130	147

**CODED**


**JUN 3 1971**

MISS. BD. OF  
 WATER CO.

DRILLERS REMARKS:

If well telescopes please sketch and show depths.

GROUND LEVEL

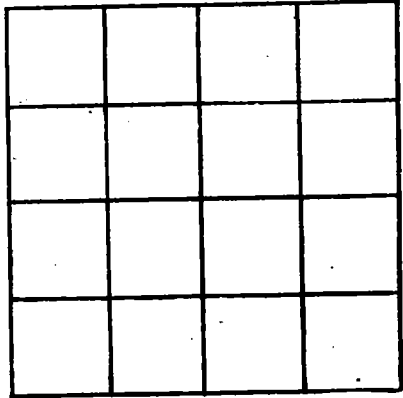

SECTION \_\_\_\_\_

Please indicate well location X.

ADDITIONAL INFORMATION

If more than one screen, show locations of each on sketch.