

C 40

4-27-63

WATER WELL DRILLERS LOG

CODED

Date: 4-27, 1963, Driller: McB Drilling Co County Harrison
(Name)

(1) Owner of Land: Faye Allison
(Name)
R.R. Saucier Miss
(Address)

(2) Location: NW 1/4, NE 1/4, Sec 19 5 R 10 W
3 miles South of Saucier
(distance) (direction) (Nearest Town)

(3) Topography: Hilly
(Hilly) (Flat) (Level)

(4) Purpose of Well: Domestic
(Domestic Irrigation
Municipal, Industrial, Other)

Description & Color of Materials Sand, Clay, Red Clay, Shell, etc.	Thick- ness Feet	Depth Feet
Bed Clay	10	10
Grey Clay	10	20
White Red Clay	60	80
White Sand + Silt	25	105
White Clay	7	112
Blue Clay	31	143
Brown Sand	22	165
Blue Clay	37	202
Grey Sand	10	212
Blue Clay	20	232
Grey Sand	5	237
Blue Clay	45	282
Grey Sand	12	294
Black Pea Gravel Size	26	320
Coarse Grey Sand	30	350

Information upon completion of well:
10 FT Top 3", Balance

(1) Diameter 2 inches.

(2) Total Depth 346 feet.

(3) Water Level 42 feet below top of ground.

(4) Cased to 332, Size 3" X 2"

(5) Screen: Size 2" X 1/2", Length 14 FT

(6) Were any formations sealed against pollution?
_____ yes, _____ no.


If YES depth of formation _____

Why _____

Drillers Remarks: _____

Still cutting sand when stopped

CODED

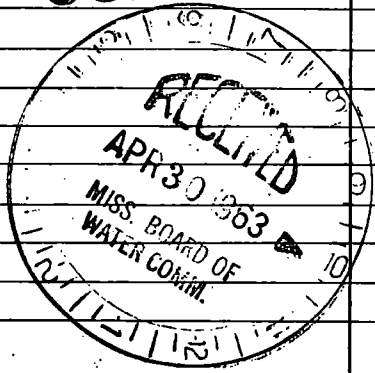

(Use Back Side)

Well No.

SECRET

[The remainder of the page contains extremely faint and illegible text, likely bleed-through from the reverse side of the document.]