

HAR.

C 41

5-9-63

WATER WELL DRILLERS LOG

Date: May 9, 1963 Driller: Joe Miller County: Harrison

(Name)

(1) Owner of Land: Barney Hadiner

(Name)

RRH Sarcier Miss

(Address)

(2) Location: _____ 1/4, _____ 1/4, Sec. _____ T. R. _____

8 miles SE of Sarcier

(distance)

(direction)

(Nearest Town)

(3) Topography: Hilly

(Hilly)

(Flat)

(Level)

(4) Purpose of Well: Domestic

(Domestic Irrigation
Municipal, Industrial, Other)

Description & Color of Materials
Sand, Clay, Red Clay, Shell, etc.

Thick-
ness
Feet

Depth
Feet

Description & Color of Materials Sand, Clay, Red Clay, Shell, etc.	Thick- ness Feet	Depth Feet
<u>Red Sand</u>	<u>25</u>	<u>25</u>
<u>Red Clay</u>	<u>5</u>	<u>30</u>
<u>White Clay</u>	<u>15</u>	<u>45</u>
<u>Red Clay</u>	<u>3</u>	<u>48</u>
<u>White Clay</u>	<u>22</u>	<u>70</u>
<u>Blue Clay</u>	<u>62</u>	<u>132</u>
<u>Brown Sand</u>	<u>16</u>	<u>148</u>
<u>Blue Clay - light</u>	<u>46</u>	<u>194</u>
<u>Break</u>	<u>2</u>	<u>196</u>
<u>Blue Clay (Hard)</u>	<u>40</u>	<u>336</u>
<u>Break - Sand Fine</u>	<u>21</u>	<u>357</u>
<u>Break Fair</u>	<u>11</u>	<u>368</u>
<u>" " Good</u>	<u>12</u>	<u>380</u>
<u>" " Finer</u>	<u>10</u>	<u>390</u>

Information upon completion of well:

(1) Diameter 2" inches.

(2) Total Depth 390 feet.

(3) Water Level 88' feet below top of ground.

(4) Cased to 370', Size 2"

(5) Screen: Size 2", Length 10'
10' tarp Rip


(6) Were any formations sealed against pollution?

_____ yes, _____ no.

If YES depth of formation _____

Why _____


Drillers Remarks: _____

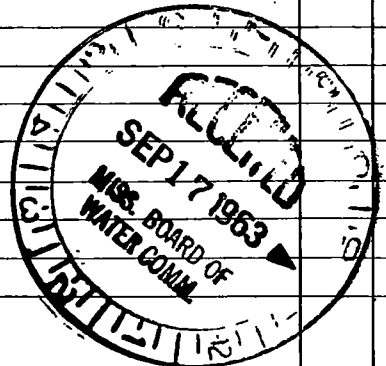

(Use Back Side)

Well No.

Mail this copy to Board of Water Commissioners 429 Miss. St. Jackson, Miss.

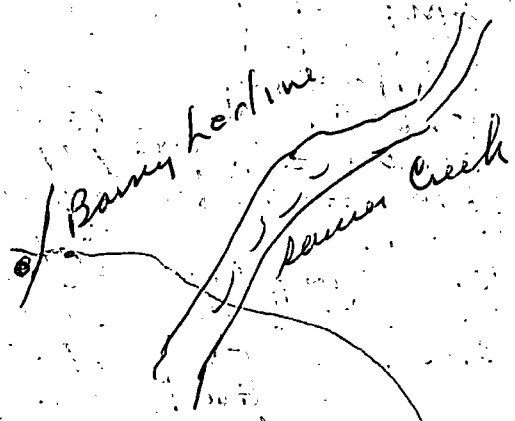

HKy 49

Savina M.S.

69

H.