

HARRISON
C 44
4-16-70

MISSISSIPPI
 BOARD OF WATER COMMISSIONERS
 416 North State Street
 Jackson, Mississippi 39201

CODED

WATER WELL DRILLERS LOG

4-16
 date well completed

1970 Parnell Anderson
 firm name

Harrison
 county well located

LANDOWNER: Simmons Service
 STATION
Saucier
 (mailing address)

description of formations encountered	from	to
<u>Red Clay</u>	<u>0</u>	<u>16</u>
<u>Fine Sand</u>	<u>16</u>	<u>21</u>
<u>Med Clay</u>	<u>21</u>	<u>40</u>
<u>Coarse Sand</u>	<u>40</u>	<u>52</u>

WELL LOCATION:
 sec. 6 T. 5 S. R. 11 W.
0 miles 0 of Saucier
 (distance) (direction) (nearest town)

WELL PURPOSE: Industrial
 (home, irrigation, municipal, industrial)

WELL COMPLETION DATA:

(1) diameter (inches) 2

(2) total depth (feet) 52

(3) static water level (feet) 20 below above top of ground.

(4) casing Plastic, 46,
 (material) (depth)
 (size) if telescope see back.

(5) screen 6, 46
 (length) (depth to top)
3, Plastic
 (size) (material)

(6) pump 1, 12
 (HP) (yield gpm)
Electric
 (type power)

(7) electric log _____
 (yes or no)

 (organization running log)

(8) how well bottom plugged
Backwash Valve

CODED


JUN 11 1971

DRILLERS REMARKS:

MISS. BD. OF
 WATER COM.

If well telescopes please sketch and show depths.

GROUND LEVEL

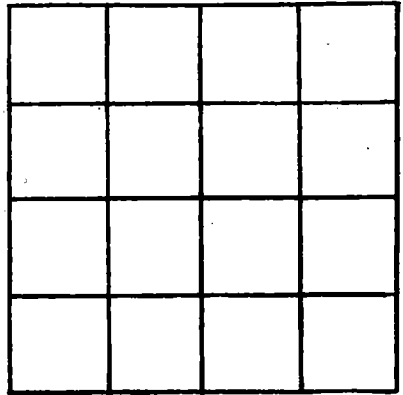

SECTION _____

Please indicate well location X.

ADDITIONAL INFORMATION

If more than one screen, show locations of each on sketch.