

C 45 N509412

8-26-63 WATER WELL DRILLERS LOG

**CODED**

Date: 8-26, 1963, Driller: Hattiesburg Butane County Harrison  
 (Name)

(1) Owner of Land: Frank Edwards  
 (Name)  
Saucier, Mississippi  
 (Address)

(2) Location: 1/4, 1/4, Sec. 6 T5R11  
Old Hi way 49  
 miles (distance) Saucier, Miss. (Nearest Town)  
 (direction)

(3) Topography: Hilly  
 (Hilly) (Flat) (Level)

(4) Purpose of Well: Domestic  
 (Domestic Irrigation, Municipal, Industrial, Other)

Description & Color of Materials Sand, Clay, Red Clay, Shell, etc.	Thick- ness Feet	Depth Feet
<u>Red Clay</u>	<u>0-5</u>	
<u>Red Sand</u>	<u>5-100</u>	
<u>Blue Clay</u>	<u>100-110</u>	
<u>Blue Sand</u>	<u>110-120</u>	
<u>Blue Clay</u>	<u>120-220</u>	
<u>Blue Sand</u>	<u>220-280</u>	

Information upon completion of well:


- (1) Diameter 2 inches.
- (2) Total Depth 280 feet.
- (3) Water Level 105 feet below top of ground.
- (4) Cased to \_\_\_\_\_, Size \_\_\_\_\_
- (5) Screen: Size 2", Length 10'
- (6) Were any formations sealed against pollution?  
 \_\_\_\_\_ yes, \_\_\_\_\_ no.

If YES depth of formation \_\_\_\_\_

Why \_\_\_\_\_

Drillers Remarks: \_\_\_\_\_

**CODED**

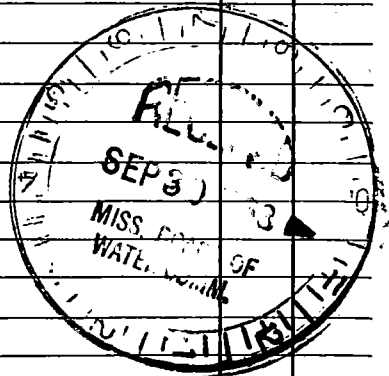

Well No.

(Use Back Side)

1900

Journal of the ...

... ..

...

...

