

HARRISON
C 46
8-5-70

MISSISSIPPI
BOARD OF WATER COMMISSIONERS
416 North State Street
Jackson, Mississippi 39201

CODED

WATER WELL DRILLERS LOG

8-5

1970 Parnell Anderson

Harrison

date well completed

firm name

county well located

LANDOWNER: R. Kilpatrick

Saucier

(mailing address)

WELL LOCATION:

sec. 19 T 5^N R 11 W
S S
5 miles S of Saucier
(distance) (direction) (nearest town)

WELL PURPOSE: Home
(home, irrigation, municipal, industrial)

WELL COMPLETION DATA:

- (1) diameter (inches) 2
- (2) total depth (feet) 336
- (3) static water level (feet) 15 below top of ground.
- (4) casing Galvanise, 326, (material) (depth),
(size) if telescope see back.
- (5) screen 10, 336, (length) (depth to top)
2", Stenlas Steel (size) (material)
- (6) pump 1 (HP) 11 (yield gpm)
Elect (type power)
- (7) electric log (yes or no)

(organization running log)

(8) how well bottom plugged Backwash Valve

description of formations encountered

from to

Top Soil	0	2
Red Clay	2	19
Fine Sand	19	27
White Clay	27	39
Blue Clay	39	210
Fine Sand	210	240
Blue Clay	240	289
Fine Sand	289	315
Coarse Sand + Gravel	315	336

CODED


JUN 11 1971

DRILLERS REMARKS:

MISS. BD. OF
WATER COMM.

If well telescopes please sketch and show depths.

GROUND LEVEL

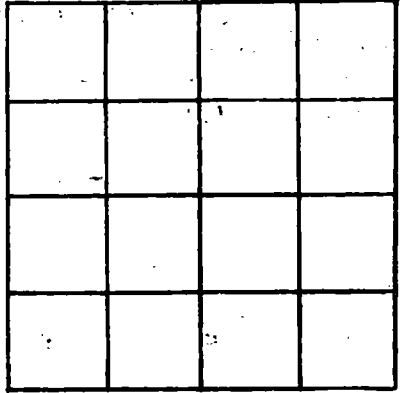

SECTION _____

Please indicate well location X.

ADDITIONAL INFORMATION

If more than one screen, show locations of each on sketch.