

CA7

MS10601

10-10-63

WATER WELL DRILLERS LOG

CODED

Date: Oct 10-10, 1963, Driller: Pittsburg Butte County Harrison (Name)

(1) Owner of Land: Curtis Scarborough (Name) Rt 1 Suisun, Miss (Address) (2) Location: 1/4, 1/4, Sec. 19, T. 5 R. 11, old 49, N. miles, of (3) Topography: X (Hilly) (Flat) (Level) (4) Purpose of Well: domestic (Domestic Irrigation Municipal, Industrial, Other)


Table with 3 columns: Description & Color of Materials, Thickness Feet, Depth Feet. Rows include yellow clay (0-8), white clay (8-38), blue clay (38-148), and blue sand (148-160).

Information upon completion of well:

(1) Diameter 2 inches. (2) Total Depth 160 feet. (3) Water Level 24 feet below top of ground. (4) Cased to, Size. (5) Screen: Size 2", Length 10'. (6) Were any formations sealed against pollution? yes, no.

CODED

If YES depth of formation Why Drillers Remarks:

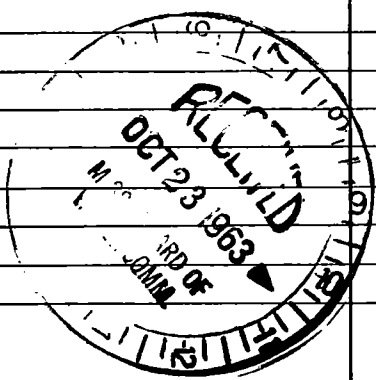

(Use Back Side)

Well No.

000000