

HARRISON

C52

1-26-71

MISSISSIPPI BOARD OF WATER COMMISSIONERS 416 North State Street Jackson, Mississippi 39201

CODED

WATER WELL DRILLERS LOG

Jan. 26 1971 date well completed L. Davis's Well Works Harrison firm name Harrison county well located

LANDOWNER: Mr. Powell

Highway 49 Sausier, Miss. (mailing address)

description of formations encountered	from to	
	from	to
yellow clay	0	40
white sand	41	61
Blue clay	62	122
Blue sand	123	150

WELL LOCATION:

sec. 18 T 5 N R 11 E (S) (W) 2 miles S of Sausier (distance) (direction) (nearest town)

WELL PURPOSE: home (home, irrigation, municipal, industrial)

WELL COMPLETION DATA:

- (1) diameter (inches) 2 inch
- (2) total depth (feet) 150 feet
- (3) static water level (feet) 30 ft. below top of ground
- (4) casing Galv. 2 inch (material) 140 ft. (depth) 2 inch (size) telescope see back.
- (5) screen 10 ft (length) 140 ft (depth to top) 2 inch (size) Stainless Steel (material)
- (6) pump 1 (HP) 6 gal. (yield gpm) Elec. (type power)
- (7) electric log NO (yes or no)
- (8) how well bottom plugged Ball check (organization running log)

CODED


JUL 21 1971

DRILLERS REMARKS:

MISS. BD. OF WATER COMM.

If well telescopes please sketch and show depths.

GROUND LEVEL

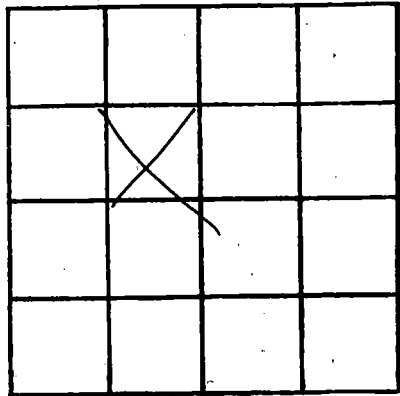

SECTION 16

Please indicate well location X.

ADDITIONAL INFORMATION

If more than one screen, show locations of each on sketch.