

C 54

NS10107

5-28-64

WATER WELL DRILLERS LOG

CODED

Date: 5-28, 1964, Driller: Hattiesburg Butte County, Harrison

(Name)

(1) Owner of Land: Kerry Powell

(Name)

Gaucier, Miss.

(Address)

(2) Location: 1/4, 1/4, Sec. 7 T5 R11

miles of (distance) (direction) (Nearest Town)

(3) Topography: (Hilly) (Flat) (Level)

(4) Purpose of Well: domestic (Domestic Irrigation Municipal, Industrial, Other)

Description & Color of Materials Sand, Clay, Red Clay, Shell, etc.

Thick-ness Feet

Depth Feet

Table with 3 columns: Description & Color of Materials, Thick-ness Feet, Depth Feet. Rows include Red clay, Red sand, Red clay, Red sand, Blue clay, Blue sand with corresponding depth ranges.

Information upon completion of well:

(1) Diameter 2 inches.

(2) Total Depth 270 feet.

(3) Water Level 58 feet below top of ground.

(4) Cased to, Size

(5) Screen: Size 2, Length 10


(6) Were any formations sealed against pollution? yes, no.

If YES depth of formation

Why

Drillers Remarks:

CODED

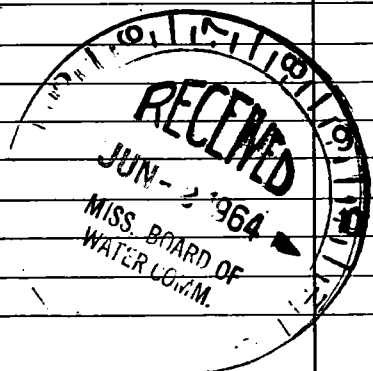

(Use Back Side)

Well No.

1111

1111

