

HAR.

MISSISSIPPI BOARD OF WATER COMMISSIONERS

C 55

092440

6-15-64

WATER WELL DRILLERS LOG

CODED

Date: June 15, 1964, Driller: Joe Melchi County Harrison

(1) Owner of Land: Spal White
(Name)
R.R.# Suicor Miss
(Address)

(2) Location: SE 1/4, NW 1/4, Sub Div
Sec. 8 P R "u"
13 miles North, of Sulphur
(distance) (direction) (Nearest Town)

(3) Topography: Hilly
(Hilly) (Flat) (Level)

(4) Purpose of Well: Domestic
(Domestic Irrigation
Municipal, Industrial, Other)

Description & Color of Materials Sand, Clay, Red Clay, Shell, etc.	Thick- ness Feet	Depth Feet
Red Clay	15	15
Red Sand & Clay	10	25
White Clay	23	48
White Clay	4	52
Fine Clay & Sand Br.	40	92
Hard Blue Clay	88	280
Fine Gray Sand	9	289
Blue Clay	21	310
Swamp Blue Sand. Fine	6	316
" " " Fair	11	327
" " " Good	31	358
Hard Blue Clay.	3	361

Information upon completion of well:

(1) Diameter 2 inches.

(2) Total Depth 361 feet.

(3) Water Level 51' feet below top of ground.

(4) Cased to 348, Size 2"

(5) Screen: Size 2", Length 10'

(6) Were any formations sealed against pollution?
 yes, no.

If YES depth of formation 10' Runy


Why _____

Drillers Remarks: _____

Aug 67 CODED

Swicher Blackledge & Samwell
on Aug 67


CODED

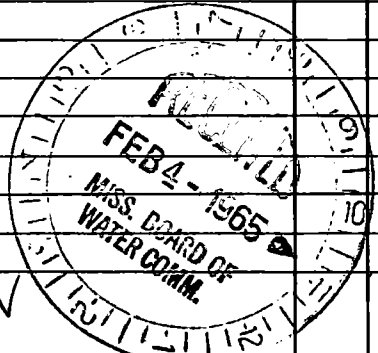

over

(Use Back Side)

Well No.

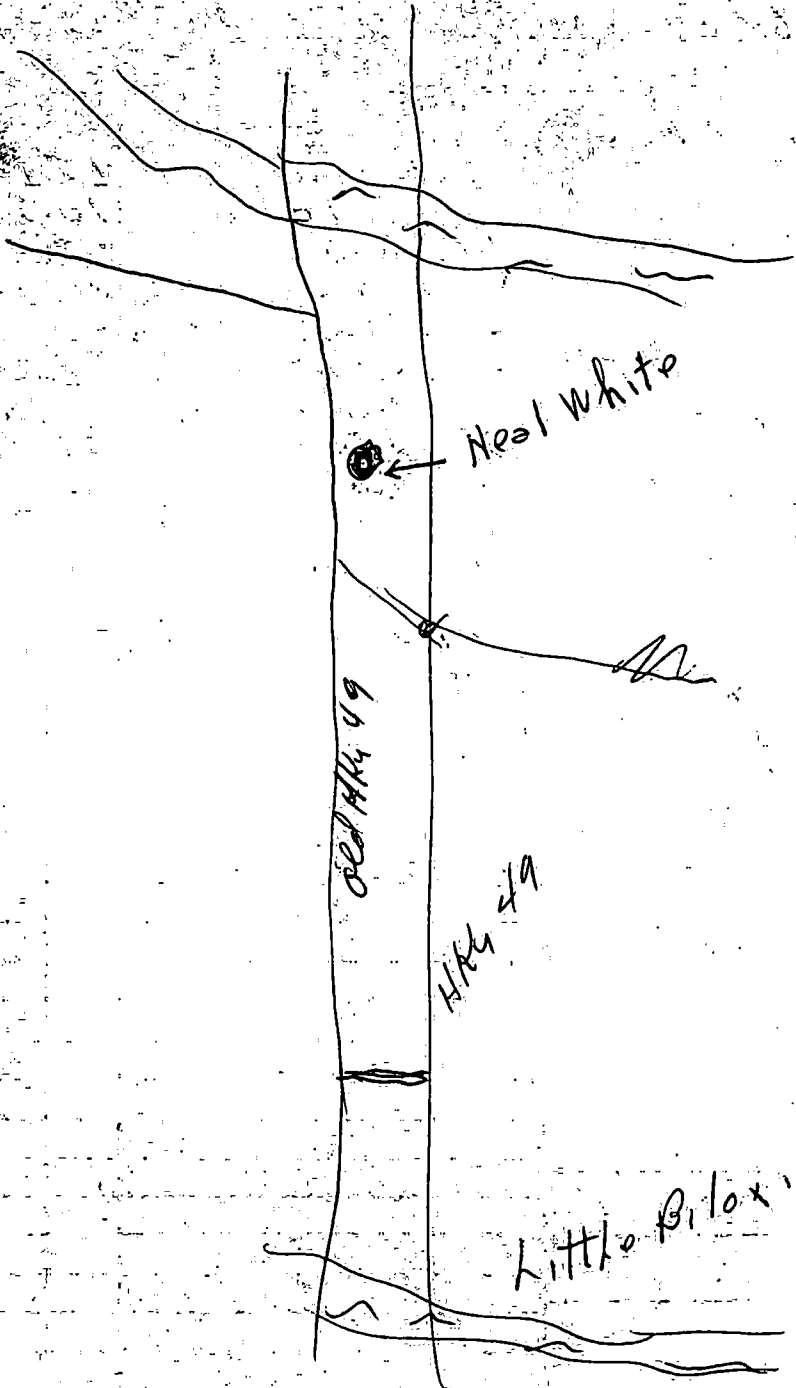

Neal White

Old Hwy 49

Hwy 49

Little Biloxi River