

Harrison
C 64
3-67

MISSISSIPPI
BOARD OF WATER COMMISSIONERS
416 North State Street
Jackson, Mississippi 39201

CODED

WATER WELL DRILLERS LOG

5-17-1967 date well completed
Switzer Well Co. firm name
Harrison county well located

LANDOWNER: Braxton Stanley
3/4 mile East of Highway 67 on
Palmer Creek Camp Ground Rd.
Rt. 1 Box 220 Shucier, Miss.
(mailing address)

WELL LOCATION:
sec. 26 T. S. R. 11 E.
S. W.
22 miles NE of GULFPORT
(distance) (direction) (nearest town)


WELL PURPOSE: Home
(home, irrigation, municipal, industrial)

WELL COMPLETION DATA:

- (1) diameter (inches) 3 x 2
- (2) total depth (feet) 430
- (3) static water level (feet) 97 below top of ground.
- (4) casing gal. steel, 420'
(material) (depth)
3 x 2 if telescope see back.
(size)
- (5) screen 10', 420'
(length) (depth to top)
3 x 2, 10 ga SS on pipe
(size) (material)
- (6) pump 1 (HP) (yield gpm)
electric
(type power)
- (7) electric log No
(yes or no)
(organization running log)
- (8) how well bottom plugged back
pressure valve

description of formations encountered	from	to
clay	0	19
coarse sand + gravel	19	22
sand + gravel	22	40
clay	40	136
fine sand	136	148
clay	148	184
sand streaks	184	191
fair sand	191	204
clay	204	217
sand	217	240
clay	240	257
sand	257	265
clay	265	362
sand	362	395
good sand	395	430


CODED

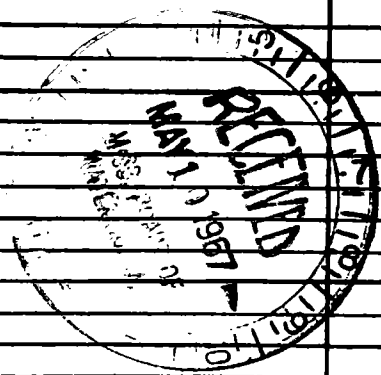

DRILLERS REMARKS:

If well telescopes please sketch and show depths.

GROUND LEVEL

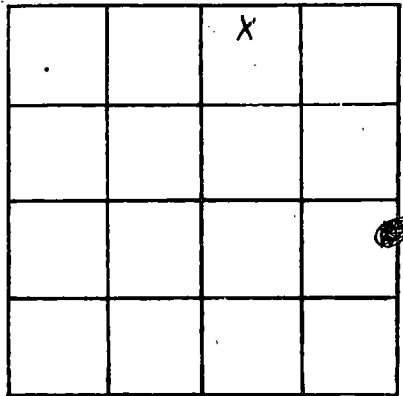

SECTION 26

Please indicate well location X.

ADDITIONAL INFORMATION

Lined area for additional information, consisting of approximately 20 horizontal lines.

If more than one screen, show locations of each on sketch.