


HARRISON  
C 65  
6-67

MISSISSIPPI  
BOARD OF WATER COMMISSIONERS  
416 North State Street  
Jackson, Mississippi

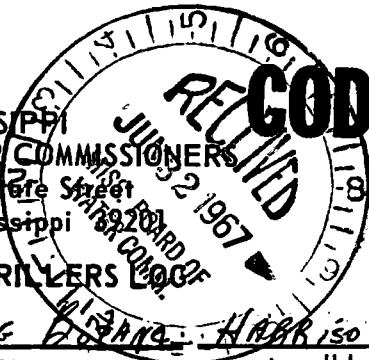

**CODED**

WATER WELL DRILLERS LOG

6-21-1967 HATTIESBURG MISSISSIPPI HARRISON  
date well completed firm name county well located

LANDOWNER: T. L. SHAVERS

RT. 1 Box 314B

Stucier Miss.  
(mailing address)

WELL LOCATION:

sec. 7 T 5 S R 11 W  
3 miles EAST of Stucier  
(distance) (direction) (nearest town)

WELL PURPOSE: Home  
(home, irrigation, municipal, industrial)

WELL COMPLETION DATA:

- (1) diameter (inches) 2"
- (2) total depth (feet) 176'
- (3) static water level (feet) 35 below above top of ground.
- (4) casing Galv. pipe, 166'  
(material) (depth)
- 2" if telescope see back.  
(size)
- (5) screen 10' 166'  
(length) (depth to top)
- 2" BRONZE  
(size) (material)
- (6) pump 1 HP 350  
(HP) (yield gpm)
- ELECTRIC  
(type power)
- (7) electric log NO  
(yes or no)
- NO  
(organization running log)
- (8) how well bottom plugged BACK WASH VALVE


description of formations encountered

from to

Red clay	0	8
white clay	9	19
Blue clay	20	42
yellow clay	43	48
white sand	49	53
white clay	54	57
Blue clay	58	62
Blue sand	63	68
Blue clay	69	158
Blue sand	159	176

**CODED**

DRILLERS REMARKS:

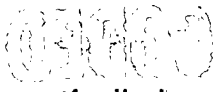

If well telescopes please sketch and show depths.

GROUND LEVEL

Large area for sketching well telescopes and depths, with faint handwritten notes.

X			

SECTION 7

Please indicate well location X.

ADDITIONAL INFORMATION

Go East on Hwy 67. Just past green turn South on dirt road.

If more than one screen, show locations of each on sketch.