

check of ...
 New...

Harrison
C 67
2-68

MISSISSIPPI
 BOARD OF WATER COMMISSIONERS
 416 North State Street
 Jackson, Mississippi 39201

CODED

WATER WELL DRILLERS LOG

2-7 1968 C.T. Switzer Well Co. Harrison
 date well completed firm name county well located

LANDOWNER: K.A. Parent
Newy 49
Saucier, Miss
 (mailing address)

WELL LOCATION:
 sec. 7 T. 5 S. R. 11 W.
1 miles S of SAUCIER
 (distance) (direction) (nearest town)

WELL PURPOSE: None
 (home, irrigation, municipal, industrial)

WELL COMPLETION DATA:

- (1) diameter (inches) 2
- (2) total depth (feet) 372
- (3) static water level (feet) 89 below above
 top of ground.
- (4) casing gal. steel 362'
 (material) (depth)
2"
 (size) if telescope see back.
- (5) screen 10', 362'
 (length) (depth to top)
8 ga., SS on pipe
 (size) (material)
- (6) pump 1 450 GPH
 (HP) (yield gpm)
electric
 (type power)
- (7) electric log No
 (yes or no)
 (organization running log)
- (8) how well bottom plugged Back
pressure valve

description of formations encountered	from	to
clay	0	5
sand	5	22
mixed	22	64
clay	64	85
mixed	85	106
clay	106	169
mixed	169	210
clay	210	226
fine sand	226	252
red sand	252	270
brown sand	270	289
good white sand	289	331
good blue sand	331	372


CODED



DRILLERS REMARKS:

If well telescopes please sketch and show depths.

GROUND LEVEL

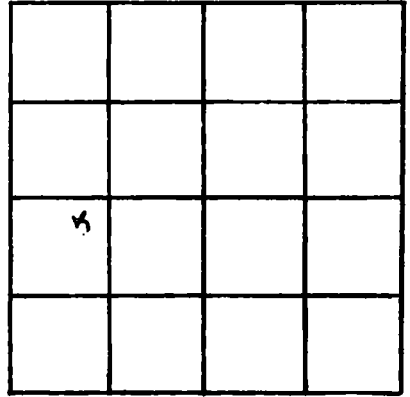

SECTION 7

Please indicate well location X.

ADDITIONAL INFORMATION

If more than one screen, show locations of each on sketch.