

Palmer Creek "strip ground"  
 Road - 1/4 road to left  
 1 1/2 miles

HARRISON
C 68
568

MISSISSIPPI  
 BOARD OF WATER COMMISSIONERS  
 416 North State Street  
 Jackson, Mississippi 39201

**CODED**

WATER WELL DRILLERS LOG

date well completed 5-1 1968 Switzer Well Co. firm name Harrison county well located

LANDOWNER: <u>Charles Horkey</u>	description of formations encountered	from	to
<u>Route 1 Box 80</u>			
<u>Saucier Miss.</u>	<u>mixed</u>	<u>22</u>	<u>43</u>
(mailing address)	<u>sand</u>	<u>43</u>	<u>53</u>
WELL LOCATION:	<u>clay</u>	<u>53</u>	<u>97</u>
sec. <u>29</u> T- <u>5</u> S	<u>fine sand</u>	<u>97</u>	<u>104</u>
R- <u>11</u> W	<u>sand</u>	<u>104</u>	<u>106</u>
<u>6</u> miles <u>N</u> of <u>LYMAN</u>	<u>clay</u>	<u>106</u>	<u>113</u>
(distance) (direction) (nearest town)	<u>sand</u>	<u>113</u>	<u>125</u>
	<u>good sand</u>	<u>125</u>	<u>148</u>

WELL PURPOSE: Home  
 (home, irrigation, municipal, industrial)

WELL COMPLETION DATA:

- (1) diameter (inches) 2
- (2) total depth (feet) 147
- (3) static water level (feet) 30' 9" below top of ground.
- (4) casing gal. steel 137'  
 (material) (depth)  
2"  
 (size) if telescope see back.
- (5) screen 10' (length), 137' (depth to top)  
8 ga. (size), SS on pipe (material)
- (6) pump 3/4 (HP), 600 gph (yield gpm)  
electric (type power)
- (7) electric log No (yes or no)

(organization running log)

(8) how well bottom plugged Back pressure valve


DRILLERS REMARKS:

**CODED**

MISSISSIPPI  
 WATER COMMISSIONERS

If well telescopes please sketch and show depths.

GROUND LEVEL

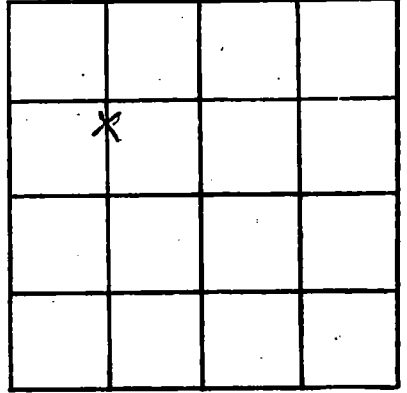

SECTION 29

Please indicate well location X.

ADDITIONAL INFORMATION

If more than one screen, show locations of each on sketch.