

CODED

Harrison
C 70
7-68

MISSISSIPPI
BOARD OF WATER COMMISSIONERS
416 North State Street
Jackson, Mississippi 39201

CODED

WATER WELL DRILLERS LOG

7-10 1968 Parnell Anderson Harrison
date well completed firm name county well located

LANDOWNER: Calvin Vogel

description of formations encountered from to

Saucier, Miss
(mailing address)

Top Soil	0	3
Red Sandy clay	3	18
Sand	18	22
Red clay	22	28
Red Sand	28	31
Red clay	31	39
Red Sand	39	49
Red Clay	49	52
Sand with Gravel	52	59

WELL LOCATION:

sec. 22 T 5 N R 11 E
S W
5 miles S-E of Saucier
(distance) (direction) (nearest town)

WELL PURPOSE: Home
(home, irrigation, municipal, industrial)

WELL COMPLETION DATA:

- (1) diameter (inches) 2"
- (2) total depth (feet) 59'
- (3) static water level (feet) 40 below top of ground.
- (4) casing Plastic, 53, (material) (depth)
- (size) If telescope see back.
- (5) screen 6, 53 (length) (depth to top)
- 6', Plastic (size) (material)
- (6) pump 1 (HP) 6 (yield gpm)
- Electricity (type power)
- (7) electric log (yes or no)

CODED

CODED


CODED

CODED

(organization running log)


(8) how well bottom plugged Back-
wash Valve

DRILLERS REMARKS:

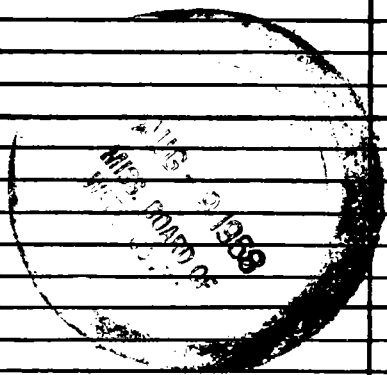

If well telescopes please sketch and show depths.

GROUND LEVEL

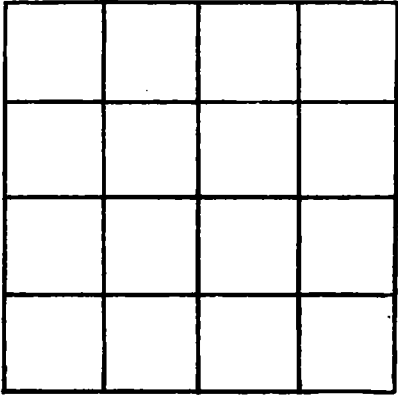

SECTION 22

Please indicate well location X.

ADDITIONAL INFORMATION

A series of horizontal lines for writing additional information, starting below the 'ADDITIONAL INFORMATION' header and extending to the bottom of the page.

If more than one screen, show locations of each on sketch.