

420 50

Harrison  
C 71  
11-8-68

MISSISSIPPI  
BOARD OF WATER COMMISSIONERS  
416 North State Street  
Jackson, Mississippi 39201

**CODED**

WATER WELL DRILLERS LOG

11-8-1968 date well completed  
Harrison county well located  
Harrison firm name

LANDOWNER: Mrs Ruby  
Cornell.  
8020159 Mrs S  
(mailing address)

description of formations encountered	from	to
	Clay Red Sand shale TD	0 22

WELL LOCATION:  
sec. 7 T5 N R. 11 E  
1 1/2 miles SW of Samburg  
(distance) (direction) (nearest town)

WELL PURPOSE: Home  
(home, irrigation, municipal, industrial)

WELL COMPLETION DATA:

(1) diameter (inches) 2"

(2) total depth (feet) 65'

(3) static water level (feet) 22' below top of ground.

(4) casing Plastic 65'  
(material) (depth)  
(size) If telescope see back.

(5) screen 5' 60'  
(length) (depth to top)  
2" PVC Plastic  
(size) (material)

(6) pump (HP) (yield gpm)  
(type power)

(7) electric log (yes or no)  
(organization running log)

(8) how well bottom plugged

**CODED**  
CODED


DEC 2 1968

MISS. Bd. OF  
WATER COM.

DRILLERS REMARKS:  
P 1/2 55' part in well.  
July 25' water

If well telescopes please sketch and show depths.

GROUND LEVEL

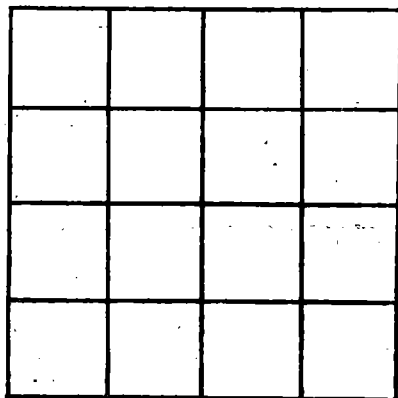

SECTION \_\_\_\_\_

Please indicate well location X.

ADDITIONAL INFORMATION

If more than one screen, show locations of each on sketch.