

Harrison
C72
10-15-68

MISSISSIPPI
 BOARD OF WATER COMMISSIONERS
 416 North State Street
 Jackson, Mississippi 39201

CODED

WATER WELL DRILLERS LOG

10-15 1968 Samuel Anderson Harrison
 date well completed firm name county well located

LANDOWNER: N. E. Neely
Lumber Co.
Bond Miss.
 (mailing address)

WELL LOCATION:
 sec. 12 T. 5 R. 11
2 miles South of Saucier
 (distance) (direction) (nearest town)

description of formations encountered	from	to
<u>Red Clay</u>	<u>0</u>	<u>24</u>
<u>Blue Clay</u>	<u>24</u>	<u>75</u>
<u>Fine Sand</u>	<u>75</u>	<u>84</u>
<u>Blue Clay</u>	<u>84</u>	<u>103</u>
<u>Loose Sand</u>	<u>103</u>	<u>119</u>

WELL PURPOSE:
 (home, irrigation, municipal, industrial)

WELL COMPLETION DATA:

(1) diameter (inches) 4"

(2) total depth (feet) 119

(3) static water level (feet) 27 below above top of ground.

(4) casing Plastic, 113
 (material) (depth)

 if telescope see back.
 (size)

(5) screen 6, 113
 (length) (depth to top)

4", Plastic
 (size) (material)

(6) pump L Sub 30
 (HP) (yield gpm)

Electric
 (type power)

(7) electric log
 (yes or no)

 (organization running log)

(8) how well bottom plugged Back Wash Valve


CODED

DEC 20 1968
 MISS. BD. OF
 WATER COM.

DRILLERS REMARKS:

If well telescopes please sketch and show depths.

GROUND LEVEL

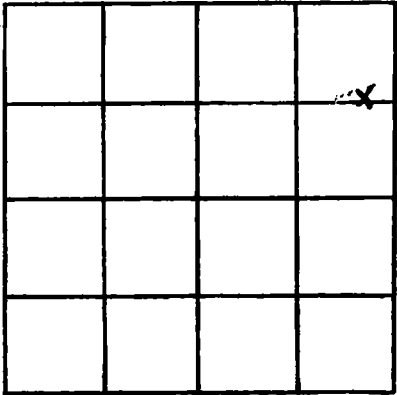

SECTION 12

Please indicate well location X.

ADDITIONAL INFORMATION

A series of horizontal lines for writing additional information.

If more than one screen, show locations of each on sketch.