

1st request 2-19-69 in person  
2nd request April 3/6/69

MISSISSIPPI  
BOARD OF WATER COMMISSIONERS  
416 North State Street  
Jackson, Mississippi 39201

WATER WELL DRILLERS LOG

**CODED**

Hanson  
C-73  
12-8-67

Dec. 8 1967 Ladner Well Works Harrison  
date well completed firm name county well located

LANDOWNER: Emergy Simmons  
Lawyer, Miss

description of formations encountered	from	to
Clay	0	60
yellow clay sand	0	60
Yellow Sand	6	feet
Blue clay	17	feet
Blue Sand	15	feet

(mailing address)


WELL LOCATION: OK  
sec. 18 T 5 N R 11 E  
S W  
2 miles South of Lawyer  
(distance) (direction) (nearest town)

WELL PURPOSE: Home  
(home, irrigation, municipal, industrial)

WELL COMPLETION DATA:

- (1) diameter (inches) 2 inch
- (2) total depth (feet) 255 feet
- (3) static water level (feet) 35 <sup>below</sup> ~~above~~ top of ground.
- (4) casing Galv., 250  
(material) (depth)  
2 inch (size) if telescope see back.
- (5) screen 5 feet, 250  
(length) (depth to top)  
008, Stainless Steel  
(size) (material)
- (6) pump 1, 10  
(HP) (yield gpm)  
Elec.  
(type power)
- (7) electric log no.  
(yes or no)  
(organization running log)
- (8) how well bottom plugged Back  
Wash Valve


**CODED**

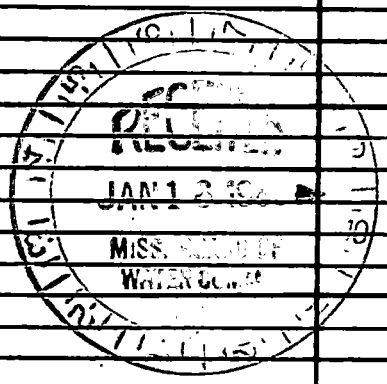

DRILLERS REMARKS:

If well telescopes please sketch and show depths.

GROUND LEVEL

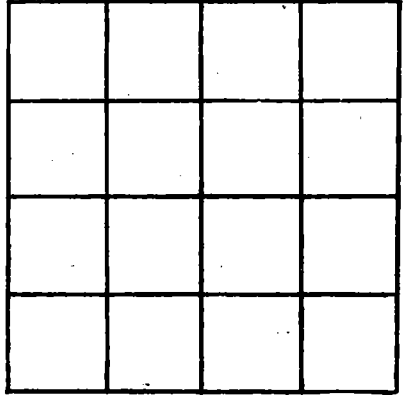

SECTION \_\_\_\_\_

Please indicate well location X.

ADDITIONAL INFORMATION

If more than one screen, show locations of each on sketch.