

Harrison
 C 83
 12-15-69

MISSISSIPPI
 BOARD OF WATER COMMISSIONERS
 416 North State Street
 Jackson, Mississippi 39201

CODED

WATER WELL DRILLERS LOG

Dec. 15 1969 Mrs. Bill Well Works HARRISON
 date well completed firm name county well located

LANDOWNER: Names Withheld
RT 1, Box 64
Saucier, Miss.
 (mailing address)

description of formations encountered	from	to
	<u>clay</u>	<u>0'</u>
<u>sand</u>	<u>180'</u>	<u>250'</u>

WELL LOCATION:
 sec. 5 T. 9 S. R. 11 E.
1 miles SE of Saucier
 (distance) (direction) (nearest town)

CODED

WELL PURPOSE: Home
 (home, irrigation, municipal, industrial)

WELL COMPLETION DATA:

(1) diameter (inches) 2"

(2) total depth (feet) 250'

(3) static water level (feet) 100' below top of ground.

(4) casing Algal (material) (depth) ←

No (size) If telescope see back.

(5) screen 10' (length) ← 240 (depth to top)

2" (size) Stainless steel (material)

(6) pump 1/2 (HP) 25 (yield gpm)

electric (type power)

(7) electric log No (yes or no)

No (organization running log)

(8) how well bottom plugged Sand

SHACK


CODED

DRILLERS REMARKS: NONE

DATE: 2-2-1969
 MISS. RD. OR
 WATER COM.

If well telescopes please sketch and show depths.

GROUND LEVEL

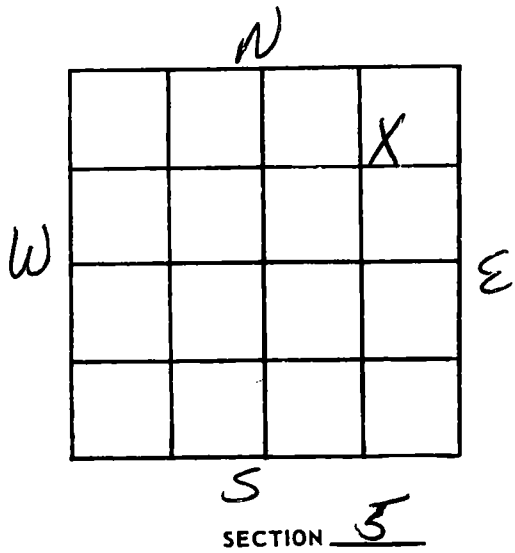

Please indicate well location X.

ADDITIONAL INFORMATION

If more than one screen, show locations of each on sketch.