

HARRISON
G87
1-26-72

TPGF

MISSISSIPPI
 BOARD OF WATER COMMISSIONERS **MAR 15 1972**
 416 North State Street
 Jackson, Mississippi 39201
WATER WELL DRILLERS LOG

CODED

1-26-72 19 R. J. Moore HARRISON
 date well completed firm name county well located

LANDOWNER:
James LuZENBERG
ShoClere, MISS
 (mailing address)

WELL LOCATION:
 sec. 12 T. 5 N. R. 11 E.
2 1/2 miles E of SHOCLERE
 (distance) (direction) (nearest town)

description of formations encountered	from	to
TOP Soil	0	10
White Clay	10	60
Red Sand	60	80
Blue Clay	80	200
grey Sand	200	262

WELL PURPOSE:
 (home) Irrigation, municipal, industrial)

WELL COMPLETION DATA:

(1) diameter (inches) 2"

(2) total depth (feet) 262'

(3) static water level (feet) 55' below above top of ground.

(4) casing 2 1/2" 252'
 (material) (depth)
 (size) if telescope see back.

(5) screen 2" x 10" 252'
 (length) (depth to top)
 (size) SS (material)

(6) pump 1 9
 (HP) (yield gpm)
E
 (type power)

(7) electric log
 (yes or no)
 (organization running log)


(8) how well bottom plugged Bad
2 1/2" pipe

CODED

DRILLERS REMARKS:

If well telescopes please sketch and show depths.

GROUND LEVEL

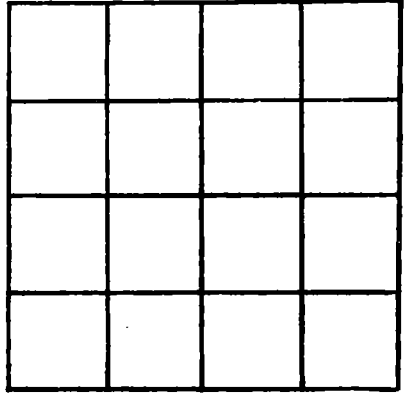

SECTION _____

Please indicate well location X.

ADDITIONAL INFORMATION

If more than one screen, show locations of each on sketch.