

**HARRISON**  
**C88**  
**1-11-72**

MISSISSIPPI  
 BOARD OF WATER COMMISSIONERS  
 416 North State Street  
 Jackson, Mississippi 39201

**CODED**

**WATER WELL DRILLERS LOG**

Jan 11 1972 Grinnell Water Well Harrison  
 date well completed firm name county well located

LANDOWNER: Benny Shaw  
Saucier, Miss

description of formations encountered	from	to
Red clay chimney	0	70
red sand & clay gravel	70	100
white clay	100	140
Blue clay silt	145	235
Water sand	235	273

(mailing address)

WELL LOCATION:  
 sec. 6 T 5 N R. 11 E  
1 miles S-E of Saucier  
 (distance) (direction) (nearest town)

WELL PURPOSE: Home  
 (home, irrigation, municipal, industrial)

WELL COMPLETION DATA:

- (1) diameter (inches) 2"
- (2) total depth (feet) 273
- (3) static water level (feet) 70 below above top of ground.
- (4) casing PVC, 273  
 (material) (depth)
- 10 If telescope see back.  
 (size)
- (5) screen 10, 263  
 (length) (depth to top)
- 2", PVC  
 (size) (material)
- (6) pump 1, 8  
 (HP) (yield gpm)
- Elec  
 (type power)
- (7) electric log N/A  
 (yes or no)
- N/A  
 (organization running log)
- (8) how well bottom plugged Sand  
Shank

**CODED**


**MAY 25 1972**

MISS. BD. OF  
 WATER COMM.

DRILLERS REMARKS:

If well telescopes please sketch and show depths.

GROUND LEVEL

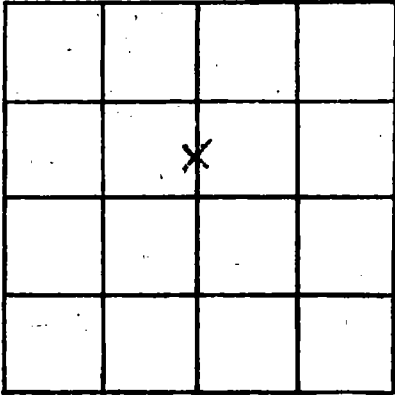

SECTION \_\_\_\_\_

Please indicate well location X.

ADDITIONAL INFORMATION

Lined area for additional information.

If more than one screen, show locations of each on sketch.