

HARRISON
C 90
2-8-72

MISSISSIPPI
BOARD OF WATER COMMISSIONERS
416 North State Street
Jackson, Mississippi 39201


WATER WELL DRILLERS LOG

Feb. 8 1972 McNeil well works Harrison
date well completed firm name county well located

| LANDOWNER: <u>W.P. Wyröddich</u> <u>159 Creswell Dr.</u> | description of formations encountered | from | to |
|--|---------------------------------------|------|-----|
| <u>Gulfport Ms.</u> (mailing address) | clay | 0 | 90 |
| WELL LOCATION: sec. <u>20</u> T <u>5</u> N R <u>11</u> E <u>7</u> miles <u>SE</u> of <u>Jaucier</u> (distance) (direction) (nearest town) | fine sand | 80 | 97 |
| WELL PURPOSE: <u>Domestic</u> (home, irrigation, municipal, industrial) | clay | 97 | 240 |
| WELL COMPLETION DATA: | <u>Coarse sand.</u> | 240 | 294 |
| (1) diameter (inches) <u>2"</u> | | | |
| (2) total depth (feet) <u>294'</u> | | | |
| (3) static water level (feet) <u>35'</u> below top of ground. above | | | |
| (4) casing <u>gal.</u> ; <u>284'</u> (material) (depth) | | | |
| _____ If telescope see back. (size) | | | |
| (5) screen <u>10'</u> , _____ (length) (depth to top) | | | |
| <u>2"</u> , _____ (size) (material) | | | |
| (6) pump <u>1</u> (HP) <u>6</u> (yield gpm) | | | |
| <u>Electric</u> (type power) | | | |
| (7) electric log <u>NO</u> (yes or no) | | | |
| <u>NO</u> (organization running log) | | | |
| (8) how well bottom plugged <u>Sandy</u> <u>Mark</u> | | | |
| DRILLERS REMARKS: | NOV 27 1972 | | |

If well telescopes please sketch and show depths.

GROUND LEVEL

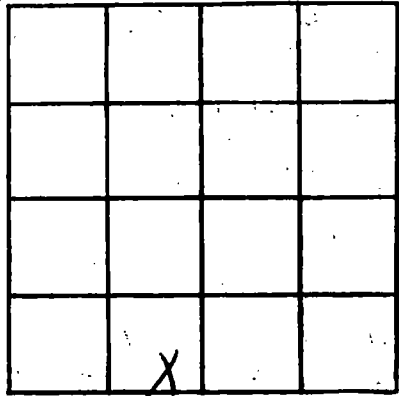

SECTION 20

Please indicate well location X.

ADDITIONAL INFORMATION

If more than one screen, show locations of each on sketch.