

HARRISON  
C91  
11-6-72

MISSISSIPPI  
BOARD OF WATER COMMISSIONERS  
416 North State Street  
Jackson, Mississippi 39201


WATER WELL DRILLERS LOG

11-6 1972 Switzer Well Co. HARRISON  
date well completed firm name county well located

LANDOWNER: <u>E. T. CLARK</u>	description of formations encountered	from	to
<u>667 HOPKINS BLVD</u>	<u>clay</u>	<u>0</u>	<u>23</u>
<u>Biloxi, Miss. 39531</u>	<u>Sand</u>	<u>28</u>	<u>44</u>
(mailing address)	<u>Clay</u>	<u>44</u>	<u>60</u>
WELL LOCATION:	<u>sand</u>	<u>60</u>	<u>85</u>
sec <u>13</u> T <u>5</u> S R <u>11</u> W	<u>clay</u>	<u>85</u>	<u>232</u>
<u>13</u> miles <u>North</u> of <u>Gulfport</u>	<u>sand</u>	<u>232</u>	<u>255</u>
(distance) (direction) (nearest town)	<u>clay</u>	<u>255</u>	<u>264</u>
WELL PURPOSE:	<u>Sand, fine</u>	<u>264</u>	<u>280</u>
(home, irrigation, municipal, industrial)	<u>sand</u>	<u>280</u>	<u>299</u>
WELL COMPLETION DATA:	<u>clay</u>	<u>299</u>	<u>301</u>
(1) diameter (inches) <u>2"</u>	<u>Clay-sand str.</u>	<u>301</u>	<u>321</u>
(2) total depth (feet) <u>427'</u>	<u>clay</u>	<u>321</u>	<u>365</u>
(3) static water level (feet) <u>134'</u> <sup>below</sup> / <sub>above</sub> top of ground.	<u>sand, fine</u>	<u>365</u>	<u>384</u>
(4) casing <u>galv.</u> <u>427'</u> (material) (depth)	<u>Sand, Good</u>		
(size) If telescope see back.			
(5) screen <u>10'</u> <u>417'</u> (length) (depth to top)			
<u>008</u> <u>stainless steel</u> (size) (material)			
(6) pump <u>1 1/2</u> <u>5</u> (HP) (yield gpm)			
<u>Electric</u> (type power)			
(7) electric log <u>no</u> (yes or no)			
(organization running log)			
(8) how well bottom plugged <u>back</u>			
<u>Pressure valve</u>			
DRILLERS REMARKS:	<u>NOV 30 1972</u>		

If well telescopes please sketch and show depths.

GROUND LEVEL

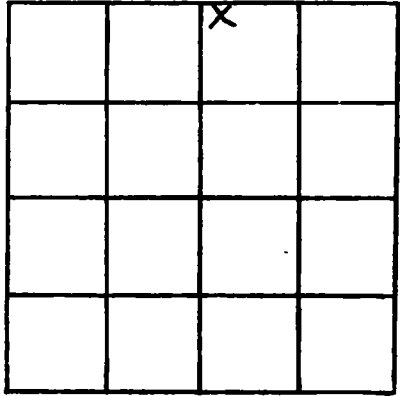

SECTION 13

Please indicate well location X.

ADDITIONAL INFORMATION

If more than one screen, show locations of each on sketch.