

HARRISON
C 96
3-20-73

MISSISSIPPI
 BOARD OF WATER COMMISSIONERS
 416 North State Street
 Jackson, Mississippi 39201

CODED


WATER WELL DRILLERS LOG

March 20 1973 M+B Drilling Co. Harrison
 date well completed firm name county well located

LANDOWNER:	description of formations encountered	from	to
David Anderson	Red sand	0	30
P.O. Sausier, Miss. (mailing address)	Red clay	30	50
WELL LOCATION: sec. <u>12</u> T. <u>5</u> S. R. <u>11</u> W. <u>5</u> miles <u>E</u> of <u>Sausier</u> (distance) (direction) (nearest town)	SAND	50	90
WELL PURPOSE: <u>Home</u> (home, irrigation, municipal, industrial)			
WELL COMPLETION DATA:	CODED		
(1) diameter (inches) <u>2"</u>			
(2) total depth (feet) <u>90</u>			
(3) static water level (feet) <u>30</u> below top of ground			
(4) casing <u>PVC</u> <u>Total</u> (material) (depth)			
<u>2"</u> (size) if telescope see back.			
(5) screen <u>10 FT.</u> <u>90</u> (length) (depth to top)			
<u>2"</u> <u>PVC</u> (size) (material)			
(6) pump <u>1</u> <u>10</u> (HP) (yield gpm)			
<u>110V 1Ø</u> (type power)			
(7) electric log <u>No</u> (yes or no)			
(organization running log)			
(8) how well bottom plugged <u>2" Backwash Valve</u>			
DRILLERS REMARKS:			

If well telescopes please sketch and show depths.

GROUND LEVEL

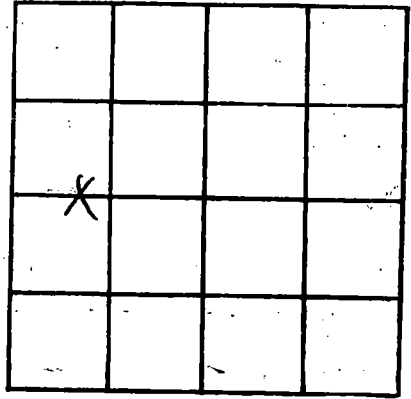

SECTION 12

Please indicate well location X.

ADDITIONAL INFORMATION

If more than one screen, show locations of each on sketch.