

**HARRISON**  
**C 101**  
**12-1-73**

MISSISSIPPI  
BOARD OF WATER COMMISSIONERS  
416 North State Street  
Jackson, Mississippi 39201

CODED

WATER WELL DRILLERS LOG

12-1-73 19 R. J. Moore HARRISON  
date well completed firm name county well located

LANDOWNER: H. TRICKARDSON

description of formations encountered  
from to

RT 1 Box 582

Shuckee, MISS  
(mailing address)

<u>TOP SOIL</u>	<u>0</u>	<u>10</u>
<u>WHITE SAND</u>	<u>10</u>	<u>30</u>
<u>WHITE CLAY</u>	<u>30</u>	<u>100</u>
<u>BLUE CLAY</u>	<u>140</u>	<u>300</u>
<u>GRASS SAND</u>	<u>300</u>	<u>330</u>

WELL LOCATION:

sec. 30 T. 5 N. R. 11 E.  
2 miles SOUTH of Shuckee  
(distance) (direction) (nearest town)

WELL PURPOSE:  
(home, irrigation, municipal, industrial)

WELL COMPLETION DATA:

- (1) diameter (inches) 2"
- (2) total depth (feet) 330
- (3) static water level (feet) 110 below above top of ground.
- (4) casing galv 320  
(material) (depth)
- If telescope see back.  
(size)
- (5) screen 10' 330'  
(length) (depth to top)
- 2" SS  
(size) (material)
- (6) pump 1 8  
(HP) (yield gpm)
- P  
(type power)
- (7) electric log       
(yes or no)
- (organization running log)
- (8) how well bottom plugged


CODED

DIC 10 1973

DRILLERS REMARKS:

If well telescopes please sketch and show depths.

GROUND LEVEL

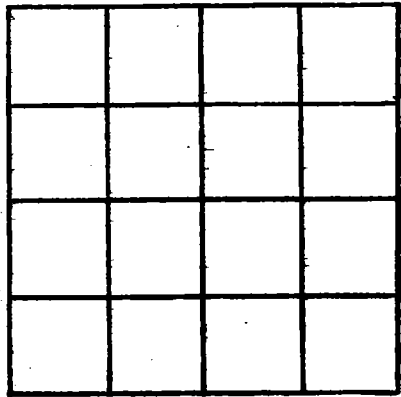

SECTION \_\_\_\_\_

Please indicate well location X.

ADDITIONAL INFORMATION

A series of horizontal lines for recording additional information.

If more than one screen, show locations of each on sketch.